

Simpson

S C13
6-66

MISSISSIPPI BOARD OF WATER COMMISSIONERS

CODED

WATER WELL DRILLERS LOG

Date: June 22, 1966, Driller: W. H. Butler County Simpson
(When well drilled) (Name) (Where well is located)

(1) Owner of Land: Charles Williams
(Name)
Braxton, Miss.
(Address)

(2) Location: NE 1/4, SW 1/4, Sec. 15, T2R3
1/2 miles S. of BRAXTON
(distance) (direction) (Nearest Town)

(3) Topography: (Hilly) (Flat) (Level)

(4) Purpose of Well: Domestic
(Domestic Irrigation
Municipal, Industrial, Other)

Description & Color of Materials Sand, Clay, Red Clay, Shell, etc.	Thick- ness Feet	Depth Feet
Red Clay + Chalk	1-	10
Chalk + Sand	10-	20
Chalk	20-	30
Chalk + Fine Sand	30-	40
Chalk + Sand	40-	50
Chalk	50-	70
Rock + Chalk	70-	160
Sand	160-	165
Sand + Chalk	165-	170
Sand	170-	194


Information upon completion of well:

- (1) Diameter 2 inches.
- (2) Total Depth 194 feet.
- (3) Water Level 111 feet below top of ground.
- (4) Cased to 189', Size 2"
- (5) Screen: Size 2", Length 5'
- (6) Were any formations sealed against pollution?
No yes, No no.

If YES depth of formation _____
Why _____

Drillers Remarks: _____
Yield in gpm: 4 gal.
Size pump: 1 HP.
Type power: electric

CODED

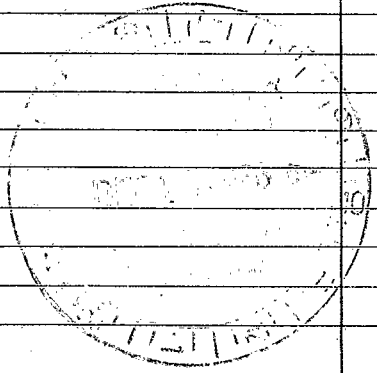

Retain this copy for your office files.

