

SIMPSON
C18
5-9-68

MISSISSIPPI **E LOG # 92**
 BOARD OF WATER COMMISSIONERS
 416 North State Street
 Jackson, Mississippi 39201
CODED
 WATER WELL DRILLERS LOG

May 9 1968 W. E. Thompson Simpson
 date well completed firm name county well located

LANDOWNER:
JAMES P. CRANE
(Brewwood)
Bryton Miss.
 (mailing address)

WELL LOCATION:
 sec. 15 T 2 N R. 3 E
1 miles S of Bryton
 (distance) (direction) (nearest town)

WELL PURPOSE: Home
 (home, irrigation, municipal, industrial)

- WELL COMPLETION DATA:
- (1) diameter (inches) 2"
 - (2) total depth (feet) 213
 - (3) static water level (feet) 58 below above top of ground.
 - (4) casing Galv. 184'
 (material) (depth)
2"
 (size) if telescope see back.
 - (5) screen 5 184'
 (length) (depth to top)
2" Plastic
 (size) (material)
 - (6) pump 1 6
 (HP) (yield gpm)
Just
 (type power)
 - (7) electric log Yes
 (yes or no)
M. N. S.
 (organization running log)
 - (8) how well bottom plugged 2/3 water

description of formations encountered	from	to
<u>Surface clay</u>	<u>0</u>	<u>5</u>
<u>yellow & grey clay</u>	<u>5</u>	<u>25</u>
<u>blue clay & rock</u>	<u>25</u>	<u>45</u>
<u>Rock!</u>	<u>45</u>	<u>53</u>
<u>Hard blue clay</u>	<u>53</u>	<u>88</u>
<u>Thin sand.</u>	<u>88</u>	<u>92</u>
<u>hard rock.</u>	<u>92</u>	<u>94</u>
<u>Blue clay</u>	<u>94</u>	<u>105</u>
<u>Rock.</u>	<u>105</u>	<u>107</u>
<u>Blue sand clay</u>	<u>107</u>	<u>115</u>
<u>Thin sand.</u>	<u>115</u>	<u>145</u>
<u>Sand.</u>	<u>145</u>	<u>212</u>
<u>Blue clay</u>	<u>212</u>	<u>213</u>

CODED


FEB 24 1971

DRILLERS REMARKS:
yield 18.2 gpm. with
air.

MISS. Bd. OF WATER COMMISSIONERS

If well telescopes please sketch and show depths.

GROUND LEVEL

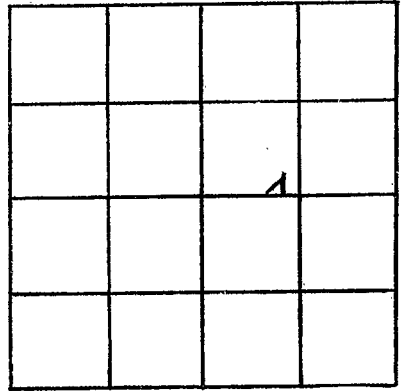

SECTION 18

Please indicate well location X.

ADDITIONAL INFORMATION

If more than one screen, show locations of each on sketch.