

13T

CODED
CODED
CODED

SIMPSON
C 22
11-2-68

MISSISSIPPI
BOARD OF WATER COMMISSIONERS
416 North State Street
Jackson, Mississippi 39201

WATER WELL DRILLERS LOG

Nov. 2 1968 T. Simpson Well Dr. Simpson
date well completed firm name county well located

LANDOWNER:
Paul G. Anderson
Bonham, Miss.
(mailing address)

description of formations encountered from to

WELL LOCATION:
sec. 6 T. 2 N. R. 3 E. SW
4 miles SW of Bonham
(distance) (direction) (nearest town)

<u>clay.</u>	<u>0</u>	<u>36</u>
<u>sand.</u>	<u>36</u>	<u>67</u>
<u>heavy clay.</u>	<u>67</u>	<u>150</u>
<u>red clay.</u>	<u>150</u>	<u>240</u>
<u>sand.</u>	<u>240</u>	<u>288</u>
<u>red clay.</u>	<u>288</u>	<u>290</u>

WELL PURPOSE: water
(home, irrigation, municipal, industrial)

WELL COMPLETION DATA:

- (1) diameter (inches) 2"
- (2) total depth (feet) 320'
- (3) static water level (feet) 246' below top of ground.
- (4) casing 2 1/2" (material), 354' (depth)
2" (size) if telescope see back.
- (5) screen 18" (length), 354' (depth to top)
1/2" (size), S.S. Onkawa (material)
- (6) pump 3/4 HP (HP), 3 gpm (yield gpm)
Red. (type power)
- (7) electric log Yes (yes or no)
Miss. W. D. (organization running log)
- (8) how well bottom plugged closed


CODED
CODED
CODED

NOV 25 1968
MISS. Bd. of
WATER COMMISSIONERS

DRILLERS REMARKS:

If well telescopes please
sketch and show depths.

GROUND LEVEL

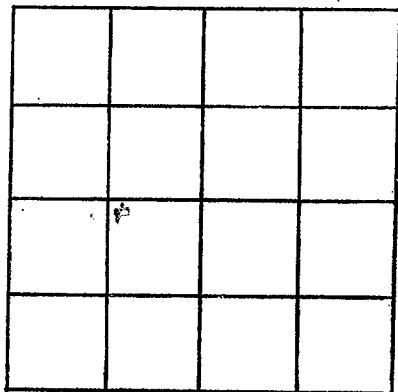

SECTION _____

Please indicate well location X.

ADDITIONAL INFORMATION

If more than one screen,
show locations of each on sketch.