

Simpson
C26
6-30-69

MISSISSIPPI
 BOARD OF WATER COMMISSIONERS
 416 North State Street
 Jackson, Mississippi 39201

CODED

WATER WELL DRILLERS LOG

6/30 1969 Foot Drilling Simpson
 date well completed firm name county well located

LANDOWNER:
Mrs. Cle Oswald,
310 North Pontiac
Jackson, Miss.
 (mailing address)

description of formations encountered	from	to
Clay	0	8
Soil	8	52
Clay + stls sand	52	61
Clay + stls rock	61	102
Clay	102	122
Clay + stls fine sand	122	142
Clay	142	184
Clay + stls silt sand	184	204
Clay	204	225
Hard shale	225	266
Hard shale + stls rock	266	286
Shale + stls fine sand	286	358
Fine sand, silty clay	358	389
Fine sand	389	409

WELL LOCATION:
 sec 31 T 2 N R 3 E
2 1/2 miles W of Harrisville
 (distance) (direction) (nearest town)

WELL PURPOSE: home
 (home, irrigation, municipal, industrial)

- WELL COMPLETION DATA:
- diameter (inches) 2"
 - total depth (feet) 409'
 - static water level (feet) 140' below top of ground.
 - casing Steel, 399'
 (material) (depth)
2" if telescope see back.
 (size)
 - screen 10', 399'
 (length) (depth to top)
2", Brass
 (size) (material) BRASS
 - pump 2 5
 (HP) (yield gpm)
Electric
 (type power)
 - electric log no
 (yes or no)
 (organization running log)
 - how well bottom plugged 2"
Backwash Valve

DRILLERS REMARKS:


CODED

JUL 11 1969

MISS. DEPT. OF
 WATER CONTROL

If well telescopes please sketch and show depths.

GROUND LEVEL

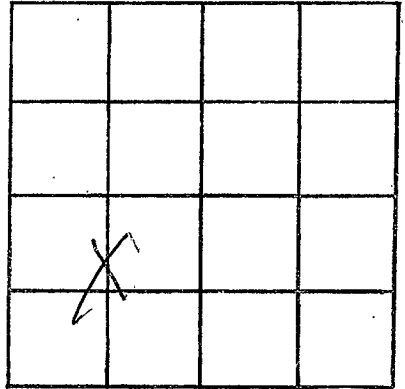

SECTION 31

Please indicate well location X.

ADDITIONAL INFORMATION

If more than one screen,
show locations of each on sketch.