

CODED

MISSISSIPPI
BOARD OF WATER COMMISSIONERS
416 North State Street
Jackson, Mississippi 39201

WATER WELL DRILLERS LOG

Simpson
C28
10-1-69

Oct. 1 1969 Thompson Well Drilling firm name Simpson county/well located

LANDOWNER:

B. L. W. W. W.

(mailing address)

WELL LOCATION:

sec. 26 T. 2 N. R. 3 E
203 1/2 miles West of P. L.
(distance) (direction) (nearest town)

WELL PURPOSE: farm home
(home, irrigation, municipal, industrial)

WELL COMPLETION DATA:

- (1) diameter (inches) 2"
- (2) total depth (feet) 240
- (3) static water level (feet) _____ below above top of ground.
- (4) casing Plastic 225 (material) (depth)
2" (size) if telescope see back.
- (5) screen 5' 225 (length) (depth to top)
2" (size) Plastic (material)
- (6) pump 3/4 (HP) 4 (yield gpm)
Out (type power)
- (7) electric log no (yes or no)
- (organization running log)
- (8) how well bottom plugged B/W/V

description of formations encountered

from to

<u>Surface</u>	<u>0</u>	<u>18</u>
<u>sand track</u>	<u>18</u>	<u>25</u>
<u>clay</u>	<u>25</u>	<u>30</u>
<u>sand</u>	<u>30</u>	<u>36</u>
<u>Blue clay</u>	<u>36</u>	<u>64</u>
<u>sand</u>	<u>64</u>	<u>70</u>
<u>Blue clay & rocks</u>	<u>70</u>	<u>224</u>
<u>sand</u>	<u>224</u>	<u>232</u>
<u>Blue clay</u>	<u>232</u>	<u>240</u>


DRILLERS REMARKS: 10' tail

B/W/V @ 240

Oct 27 1969
MISS. BO. OF WATER COMMISSIONERS

If well telescopes please sketch and show depths.

GROUND LEVEL

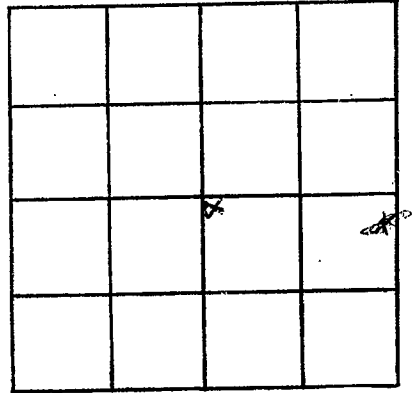

SECTION 26

Please indicate well location X.

ADDITIONAL INFORMATION

If more than one screen,
show locations of each on sketch.