

SIMPSON
C 30
6-27-70

MISSISSIPPI
BOARD OF WATER COMMISSIONERS
416 North State Street
Jackson, Mississippi 39201

WATER WELL DRILLERS LOG

CODED

June 27 1970 H. E. Thompson Simpson
date well completed firm name county well located

LANDOWNER:
J. R. Leming
B. Rayton miss
(mailing address)

WELL LOCATION:
sec. 29 T 2 N R 3 E
2 1/2 miles SW of Rayton
(distance) (direction) (nearest town)

WELL PURPOSE: Home
(home, irrigation, municipal, industrial)

- WELL COMPLETION DATA:
- (1) diameter (inches) 2 1/2"
 - (2) total depth (feet) 427
 - (3) static water level (feet) 300 below above top of ground.
 - (4) casing Plastic 181'
(material) (depth)
2" if telescope see back.
(size)
 - (5) screen 15' 181'
(length) (depth to top)
2" Plastic
(size) (material)
 - (6) pump 2 6
(HP) (yield gpm)
 - (7) electric log Inst.
(yes or no)
(organization running log)
 - (8) how well bottom plugged Blowdown

description of formations encountered	from	to
Top soil	0	24
White sand.	24	80
Blue clay.	80	153
Thin sand.	153	210
Blue clay	210	370
sand.	370	427

CODED


made well @ 427'
Water level 300'
Drilled no 2 hole
206

DRILLERS REMARKS:

JUL 1 1970

If well telescopes please sketch and show depths.

GROUND LEVEL

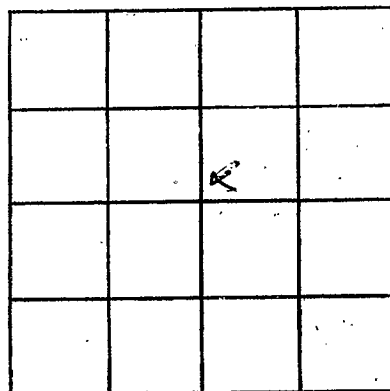

SECTION 29

Please indicate well location X.

ADDITIONAL INFORMATION

If more than one screen,
show locations of each on sketch.