

Simpson  
C 139  
9-72

MISSISSIPPI  
 BOARD OF WATER COMMISSIONERS  
 416 North State Street  
 Jackson, Mississippi 39201

CODED

WATER WELL DRILLERS LOG

Sept 1st 19 72  
 date well completed

Hanni Well Service  
 firm name

Simpson  
 county well located

LANDOWNER: Harold Barrett  
Route # 2  
Braxton Miss 39044  
 (mailing address)

WELL LOCATION:  
 sec. 30 T. 2 N. R. 3 E. 13 T  
 S W  
5 miles S-W of Braxton  
 (distance) (direction) (nearest town)

WELL PURPOSE: Home  
 (home, irrigation, municipal, industrial)

- WELL COMPLETION DATA:
- (1) diameter (inches) 7
  - (2) total depth (feet) 222
  - (3) static water level (feet) 53 below  
 top of ground. 170 above
  - (4) casing Galvase 170 off  
 (material) (depth)  
 (size) If telescope see back.
  - (5) screen 5  
 (length) (depth to top)  
2 Brass  
 (size) (material)
  - (6) pump 1-MS  
 (HP) (yield gpm)  
Effect  
 (type power)
  - (7) electric log no  
 (yes or no)  
 (organization running log)
  - (8) how well bottom plugged fair

description of formations encountered	from	to
Red clay	0	20
Brown dirt	20	40
Yellow clay	40	50
Blue clay + Rock	50	70
Brown Rock	70	82
Blue clay	82	92
Dirt	92	117
Tri colored Rock	117	132
Brown Rock	132	152
Blue Rock	152	157
Blue clay	157	162
Fine sand mixed dirt	162	182
course sand	182	202
Blue clay	202	207
White sand	207	222

CODED


RECEIVED  
 SEP 15 1972

MISS. BOARD OF WATER COMMISSIONERS

DRILLERS REMARKS:

If well telescopes please sketch and show depths.

GROUND LEVEL

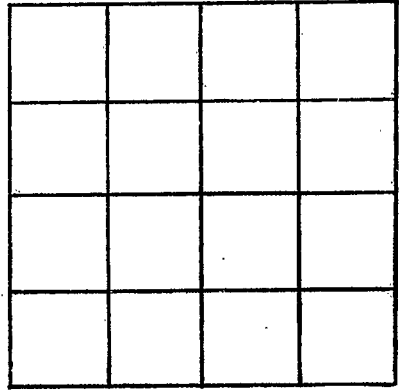

SECTION \_\_\_\_\_

Please indicate well location X.

ADDITIONAL INFORMATION

If more than one screen, show locations of each on sketch.