

SIMPSON  
C44  
8-24-77  
Elog # 188

MISSISSIPPI  
BOARD OF WATER COMMISSIONERS  
416 North State Street  
Jackson, Mississippi 39201

WATER WELL DRILLERS LOG

8-27 1977 date well completed  
27 Guinn water well Simpson firm name  
SIMPSON county well located


LANDOWNER: SIMONS, S  
(mailing address)  
WELL LOCATION:  
sec. 26 T. 2 N. R. 3 E. S. W.  
3 miles S of BRAYTON  
(distance) (direction) (nearest town)

description of formations encountered	from	to
CLAY	0	100
SAND	60	70
CLAY	70	280
SAND	250	280

WELL PURPOSE:  
(home, irrigation, municipal, industrial)


WELL COMPLETION DATA:  
(1) diameter (inches) 4"  
(2) total depth (feet) 280  
(3) static water level (feet) 110 below above top of ground.  
(4) casing PVC, 2100 (material) (depth)  
1 1/2" if telescope see back. (size)  
(5) screen 20, 260 (length) (depth to top)  
1 1/2" PVC (size) (material)  
(6) pump 3A, 10 (HP) (yield gpm)  
(type power)  
(7) electric log (yes or no)  
MGS (organization running log)  
(8) how well bottom plugged 13WU

DRILLERS REMARKS:

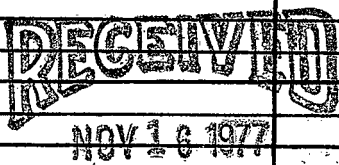

If well telescopes please sketch and show depths.

GROUND LEVEL

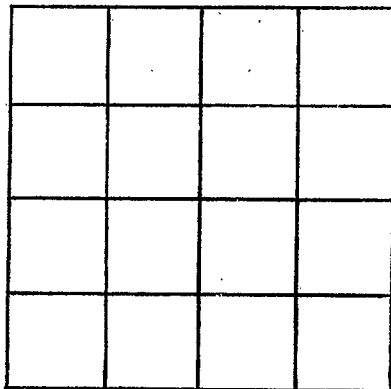

SECTION \_\_\_\_\_

Please indicate well location X.

ADDITIONAL INFORMATION

If more than one screen, show locations of each on sketch.