

SIMPSON  
C52  
9-26-78  
Elog #221

MISSISSIPPI  
BOARD OF WATER COMMISSIONERS  
416 North State Street  
Jackson, Mississippi 39201 CODED

WATER WELL DRILLERS LOG

9-26-1978 Quinn Water Well Co Simpson  
date well completed firm name county well located

LANDOWNER:  
CALVARY BAPTIST CHURCH  
(mailing address)

description of formations encountered	from	to
CLAY	0	170
SAND	170	296

WELL LOCATION:  
sec. 11 T. 2 N. R. 3 E  
S W  
miles of  
(distance) (direction) (nearest town)

CODED

WELL PURPOSE:  
(home, irrigation, municipal, industrial)


WELL COMPLETION DATA:  
(1) diameter (inches) 2"  
(2) total depth (feet) 296  
(3) static water level (feet) 98 below top of ground.  
(4) casing PVC 156  
(material) (depth)  
2 if telescope see back.  
(size)  
(5) screen 20 176  
(length) (depth to top)  
2 PVC  
(size) (material)  
(6) pump 1 4  
(HP) (yield gpm)  
(type power)  
(7) electric log yes (yes or no)  
MOS  
(organization running log)  
(8) how well bottom plugged BW

DRILLERS REMARKS:

URGENT  
OCT 25 1978

If well telescopes please sketch and show depths.

GROUND LEVEL

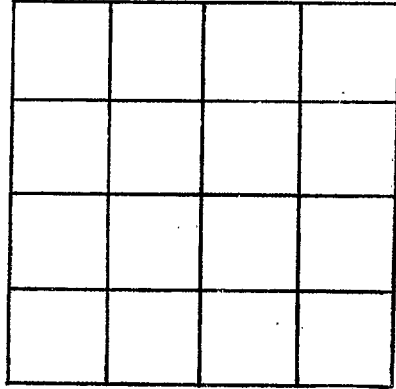

SECTION \_\_\_\_\_

Please indicate well location X.

ADDITIONAL INFORMATION

If more than one screen, show locations of each on sketch.