

SIMPSON
 CSB
 11-27-78
 E Log # ~~219222~~
 11-27-78 19

MISSISSIPPI
 BOARD OF WATER COMMISSIONERS
 416 North State Street
 Jackson, Mississippi 39201

CODED

CODED

WATER WELL DRILLERS LOG

Guinn Waterwell Co SIMPSON
 date well completed firm name county well located

LANDOWNER:
 HANK SENSEN

description of formations encountered	from	to
C.L.A. & SAND	0	170
	170	205

(mailing address)

WELL LOCATION:
 sec. 10 T. 2 N R. 3 E

(distance) miles (direction) of (nearest town)

WELL PURPOSE:
 (home, irrigation, municipal, industrial)

WELL COMPLETION DATA:

- (1) diameter (inches) 4
- (2) total depth (feet) 205
- (3) static water level (feet) 40 below top of ground.
- (4) casing PVC 145 (material) (depth)
- 4 (size) if telescope see back.
- (5) screen 20 145 (length) (depth to top)
- 4 PVC (size) (material)
- (6) pump 3/4 15 (HP) (yield gpm)
- (type power)
- (7) electric log (yes or no)
- MGS (organization running log)
- (8) how well bottom plugged B.W.V

CODED


CODED

RECEIVED
 DEC 13 1978

DRILLERS REMARKS:

If well telescopes please sketch and show depths.

GROUND LEVEL

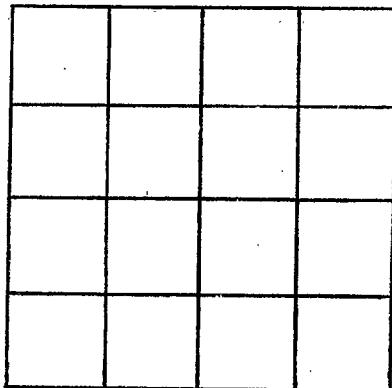

SECTION _____

Please indicate well location X.

ADDITIONAL INFORMATION

If more than one screen, show locations of each on sketch.