

GW 01088

SIMPSON
C 58
5/81
E log #263
MAY 1981

MISSISSIPPI
BOARD OF WATER COMMISSIONERS
416 North State Street
Jackson, Mississippi 39201

CODED

WATER WELL DRILLERS LOG

date well completed 1981 firm name GRINER DRILLING SER. SIMPSON county well located _____

LANDOWNER: HARRISVILLE WATER ASSOCIATION
WELL NO. 2
(mailing address)

description of formations encountered	from	to
Top soil	0	3
SAND + CLAY streaks	3	40
CLAY	40	212
SAND + CLAY streaks	212	224
1/4 SAND, fine	224	250
SAND + CLAY	250	292
CLAY within SAND streaks	292	576
CLAY	576	1092
SAND + CLAY streaks	1092	1104
SAND fine	1104	1222
CLAY + rocks	1222	1270


WELL LOCATION: SW 1/4 SE 1/4 SW 1/4
sec. 19 T. 2 N. R. 3 E. S. 5 W.

(distance) miles _____ of _____ (direction) _____ of _____ (nearest town)

WELL PURPOSE:
(home, irrigation, municipal, industrial)

- WELL COMPLETION DATA:
- (1) diameter (inches) 10 3/4
 - (2) total depth (feet) 1150 ft.
 - (3) static water level (feet) 200.20 below top of ground.
 - (4) casing steel 1102
(material) (depth)
 - 10 3/4 If telescope see back.
(size)
 - (5) screen 40 1112
(length) (depth to top)
6" 309 S.S. (016)
(size) (material)
 - (6) pump 30 200
(HP) (yield gpm)
 - Elect.
(type power)
 - (7) electric log YES
(yes or no)
 - MGS
(organization running log)
 - (8) how well bottom plugged BARK
WASH VALVE

CODED

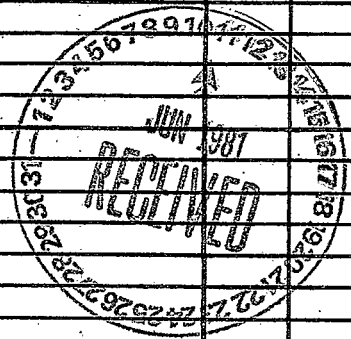


DRILLERS REMARKS: _____



If well telescopes please sketch and show depths.

GROUND LEVEL

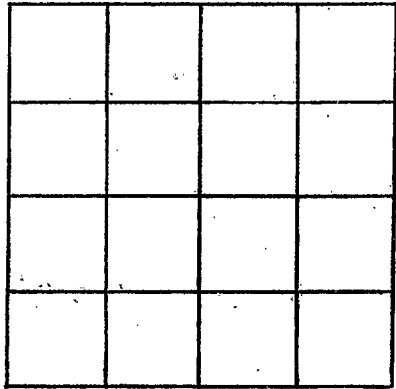

SECTION _____

Please indicate well location X.

ADDITIONAL INFORMATION

If more than one screen, show locations of each on sketch.