

MISSISSIPPI DEPARTMENT OF NATURAL RESOURCES

Bureau of Land and Water Resources

Southport Mall

P.O. Box 10631

Jackson, Mississippi 39209

WATER WELL DRILLERS LOG

SIMPSON
~~659~~ **C59**
4-16-82

April 16 1982 Rever Miller Simpson
 date well completed firm name county well located

LANDOWNER:	description of formations encountered	from	to
<u>James Kysar</u> <u>Brauxton</u> (mailing address)	<u>Play gravel</u>	<u>0</u>	<u>25</u>
	<u>hard blue clay</u>	<u>25</u>	<u>240</u>
	<u>fine sand</u>	<u>240</u>	<u>265</u>
	<u>Coarse sand</u>	<u>265</u>	<u>285</u>
WELL LOCATION: sec. <u>15</u> T. <u>2</u> N. R. <u>3</u> E <u>1 1/2</u> miles <u>S-SW</u> of <u>Brauxton</u> (distance) (direction) (nearest town)			
WELL PURPOSE: <u>houses</u> (home, irrigation, municipal, industrial)			
WELL COMPLETION DATA:			
(1) diameter (inches) <u>4"</u>			
(2) total depth (feet) <u>285'</u>			
(3) static water level (feet) <u>165'</u> below top of ground.			
(4) casing <u>Plastic bottom</u> (material) (depth)			
<u> </u> if telescope see back. (size)			
(5) screen <u>10'</u> <u>275'</u> (length) (depth to top)			
<u>1 1/2"</u> <u>Plastic</u> (size) (material)			
(6) pump <u>1/2</u> <u>15</u> (HP) (yield gpm)			
<u>elect</u> (type power)			
(7) electric log <u>no</u> (yes or no)			
<u> </u> (organization running log)			
(8) how well bottom plugged <u>each wash</u>			
DRILLERS REMARKS:			


DEPT. OF NATURAL RESOURCES
 BUREAU OF LAND & WATER RESOURCES

AUG - 5 1982

RECEIVED

If well telescopes please sketch and show depths.

GROUND LEVEL

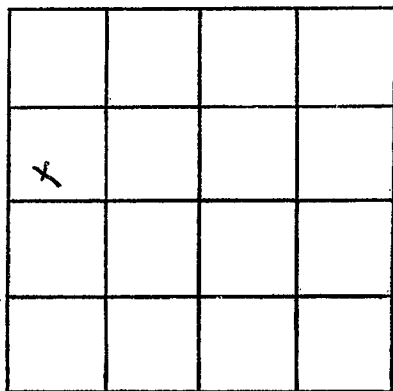

SECTION 15

Please indicate well location X.

ADDITIONAL INFORMATION

If more than one screen, show locations of each on sketch.