

MISSISSIPPI DEPARTMENT OF NATURAL RESOURCES
 Bureau of Land and Water Resources
 Southport Mall
 P.O. Box 10631
 Jackson, Mississippi 39209
WATER WELL DRILLERS LOG

CODED

Simpson
C 65

6-19
 date well completed

1987 Roy U. West Dr'g
 firm name

Simpson
 county well located

LANDOWNER:
J. E. Albritton James
Braxton MS
 (mailing address)

description of formations encountered	from	to
CLAY	0	8
SAND CLAY STRKS	8	54
CLAY	54	158
SAND	158	163
CLAY	163	303
SAND	363	390

WELL LOCATION:
 sec. 19 T. 2 N. R. 3 E.
 5 W
6 miles SW of Braxton
 (distance) (direction) (nearest town)

WELL PURPOSE:
 (home, irrigation, municipal, industrial)

CODED

WELL COMPLETION DATA:

- (1) diameter (inches) 4"
- (2) total depth (feet) 390'
- (3) static water level (feet) 160' below above top of ground.
- (4) casing PVC, 380'
 (material) (depth)
4" if telescope see back.
 (size)
- (5) screen 10', 380'
 (length) (depth to top)
4", PVC
 (size) (material)
- (6) pump 3, 40
 (HP) (yield gpm)
REA
 (type power)
- (7) electric log NO
 (yes or no)

RECEIVED

AUG 26 1987

Department of Natural Resources
 Bureau of Land & Water Resources


(organization running log)

(8) how well bottom plugged
WASH VALVE

DRILLERS REMARKS:

If well telescopes please
sketch and show depths.

GROUND LEVEL

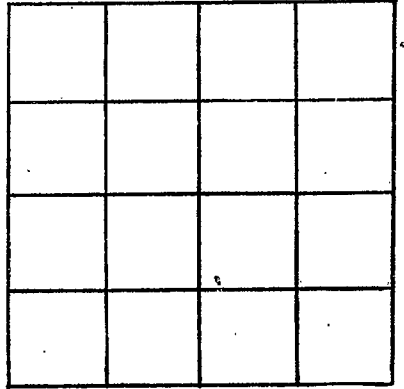

SECTION _____

Please indicate well location X.

ADDITIONAL INFORMATION

If more than one screen,
show locations of each on sketch.