




If well telescopes please sketch and show depths.

GROUND LEVEL

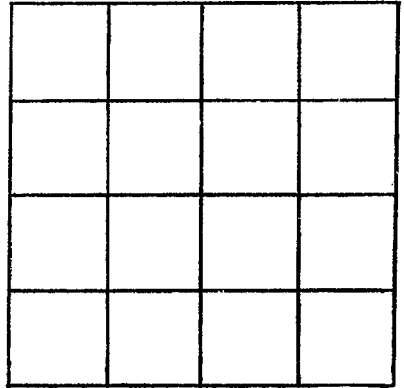

SECTION \_\_\_\_\_

Please indicate well location X.

ADDITIONAL INFORMATION

*[Faint, illegible text]*

If more than one screen,  
show locations of each on sketch.