

### STATE WELL REPORT

#### Part 1

#### Driller's Log

Mississippi Department of Environmental Quality  
 Office of Land and Water Resources  
 P.O. Box 2309  
 Jackson, MS 39225-2309  
 (601)961-5210  
 (601)360-0535 (fax)

#### For Office Use Only:

Well #: C91  
 Aquifer: \_\_\_\_\_  
 E-Log #: \_\_\_\_\_

County: Simpson  
 Permit #: \_\_\_\_\_  
 Driller: David Vest  
 Date drilling completed: 8-4-2017

*State Law requires that this report be prepared by the license holder responsible for the work and filed with the Department at the above address within 30 days of completion of drilling of the well or borehole.*

Well Owner Information <i>(Landowner if borehole is not for a water well)</i>	Well or Borehole Location
Owner Name: <u>Brian Birney</u>	Latitude: <u>32° 02.712</u> Longitude: <u>90° 01.823</u>
Mailing Address: <u>400 Clark Rd</u>	<u>32-02-43</u> <u>90-01-49</u>
City: <u>Boston</u> State: <u>MS</u> Zip Code: _____	Method of Lat/Long (check one): Conventional Survey _____
Telephone No. (601) <u>940-5220</u>	USGS quad _____, Hand-held GPS <input checked="" type="checkbox"/> Survey-grade GPS _____
	<u>NE</u> <u>SE</u> <u>SW</u> <u>NW</u> 1/4, Sec <u>16</u> T <u>2N</u> R <u>2E</u>
	<u>3</u> Miles <u>NE</u> of <u>Boston, MS</u>
	(Distance) (Direction) (Nearest Town)

**Well / Borehole Data**

Date drilling started: 8-3-17 Date drilling completed: 8-4-17 Hole depth: 352' Hole diameter: 6 1/2"

Location of the source of any surface water used for drilling: Creechon Clark Rd.

Method of dosing and volume of Chlorine used in drilling and development: Tab's 50PPM

Logs run (circle all applicable):  No log run  Electric  Gamma Ray  Density  Sonic  Neutron Other: \_\_\_\_\_

Name of organization running log(s): \_\_\_\_\_

Purpose of borehole (circle one): Water Well  Geotechnical/Geological Investigation  Ground Source Heat Pump   
 Seismic Survey  Other (describe) \_\_\_\_\_

*If drilling is not related to water well construction, skip the remainder of this block*

Purpose of Well (circle all applicable):  Home  Industrial  Public Supply  Irrigation  Fish Culture

Other (describe): \_\_\_\_\_

If a flowing well, method of flow regulation: Valve \_\_\_\_\_ Other (describe) \_\_\_\_\_

Static Water Level: 251 feet [above or  below] land surface Date measured: 8-4-2017  
 (circle one)

Method of measurement (circle one): Steel tape  Electric tape  Air line  Other (describe): Sonar

Well depth: 352 Well grouted to a depth of: 40 feet Type of grout (circle one): Neat Cement  Bentonite  Mix

Casing length: 332 feet Casing diameter: 4 inches Type of casing: PVC

Screen length: 20 feet Screen diameter: 4 inches Type of screen: PVC

Screen slot size: .008 inches Setting depth: From 332 feet to 352 feet

Type of completion (circle all applicable):  Gravel packed  Underreamed  Open hole  Natural Development

Other (describe): \_\_\_\_\_

Top of lap pipe or reduction in casing: \_\_\_\_\_ feet


*If telescoped or more than one screen, describe on next page*

County: Simpson  
 Permit #: \_\_\_\_\_

**For Office Use Only:**  
 Well #: C91

The sketch below only required for water wells

If well telescopes, show depths on sketch.

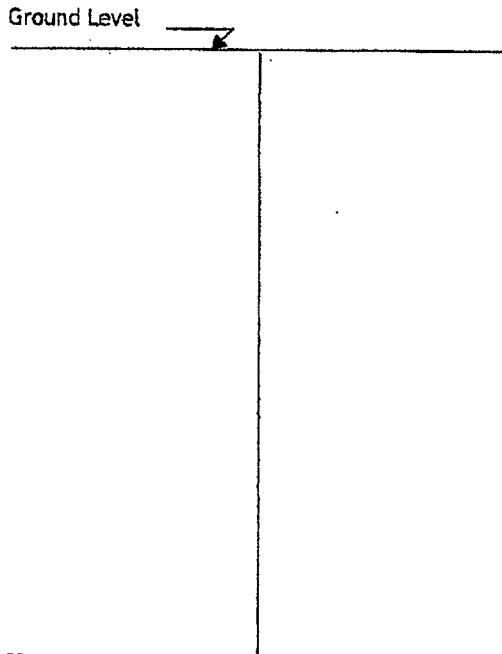

Description of formations encountered must be provided for all wells and boreholes, unless specifically exempted by regulations

Description of Formations Encountered	From (depth)	To (depth)
Sandy Clay	Ground level	14
Clay	14	38
Sand	38	112
Clay w/rocks	112	164
clay	164	325
Sandy	325	331
Sand	331	352

If more than one screen, show location of each on sketch

Sketch the property layout and include the following:  
 1) the well location  
 2) any permanent structures on the property that may aid in locating the well  
 3) any roads, power lines, or other items that may aid in locating the property and the well  
 4) north arrow

Landowner Name: Brian Birney

I HEREBY CERTIFY that the well/borehole was drilled, constructed, and completed in accordance with all applicable requirements of the Mississippi Department of Environmental Quality and the Mississippi Department of Health regulations, if applicable, and state laws.

David West 0-692      8-9-2017      [Signature]  
 Print Name of Responsible Licensee and License No.      Date      Signature of Licensee

### STATE WELL REPORT

#### Part 2

**Pump Installer's Completion Report**  
 Mississippi Department of Environmental Quality  
 Office of Land and Water Resources  
 P.O. Box 2309  
 Jackson, MS 39225-2309  
 (601)961-5210  
 (601) 360-0535 (fax)

County: Simpson  
 Permit #: \_\_\_\_\_  
 Driller: David West  
 Date completed: 8-4-2017  
*Copy information from block on Part 1*

**For Office Use Only:**  
 Well #: Ca1  
 Aquifer: \_\_\_\_\_

*This part of the report must be completed by a licensed water well contractor or a licensed pump installer. A copy of Part 1 of the report must be attached and both parts filed with the Department at the above address within 30 days of well completion.*

Well Owner Information		Well Location	
Owner Name: <u>Brian Birney</u>	Latitude: <u>32°08.912</u>	Longitude: <u>90°01.823</u>	
Mailing Address: <u>400 Clark Rd.</u>	<u>32-02-43</u>	<u>90-01-49</u>	
<u>Braxton</u> <u>MS</u>	Method of Lat/Long (check one): <input type="checkbox"/> Conventional Survey _____		
City State Zip Code	USGS quad _____, Hand-held GPS <input checked="" type="checkbox"/> Survey-grade GPS _____		
Telephone No. <u>(601) 940-5222</u>	<u>NE 1/4 SW 1/4</u>	Sec <u>X6 T 2N R 2E</u>	
	<u>3</u> Miles <u>NE</u> of <u>Braxton</u>	<u>SE</u>	
	(Distance) (Direction) (Nearest Town)		

**Pump Type (check one)**  
 Submersible  Turbine  Air Lift  Centrifugal  Flowing Well  Jet  Piston  Rotary  Other (describe): \_\_\_\_\_  
 Date Pump Installed: 8-4-2017 Rated Pump Capacity: 10 Gallons Per Minute  
 Is This Pump (check one):  New  Repaired  Replacement

**Power Type (check one)**  
 Electric  Diesel  Gasoline  Natural Gas  Tractor PTO  Windmill  Other (describe): \_\_\_\_\_  
 Horse Power Rating of Motor: 1.5HP. Setting Depth: 300 feet Number of Stages: \_\_\_\_\_

**Pump Test Data for Non Flowing Well**  
 Date Well Tested: \_\_\_\_\_ Duration of Pump Test (minimum 4 hours): \_\_\_\_\_ hours  
 Static Water Level (A): \_\_\_\_\_ Feet Below Land Surface Pumping Water Level (B): \_\_\_\_\_ Feet Below Land Surface  
 Drawdown [(B) - (A)]: \_\_\_\_\_ Feet Below Land Surface Test Pumping Rate: \_\_\_\_\_ Gallons Per Minute  
 Method of measurement (check one):  Steel tape  Electric tape  Air line  Other (describe): \_\_\_\_\_

**Pump Test Data for Flowing Well**  
 Measured shut in head: \_\_\_\_\_ feet.  
 Well yielded \_\_\_\_\_ GPM with a drawdown of \_\_\_\_\_ feet after \_\_\_\_\_ hours of pumping

**Meter Installation**  
 Meter Manufacturer: \_\_\_\_\_ Meter Serial Number: \_\_\_\_\_  
 Meter Model Number/Name: \_\_\_\_\_ Type of Meter: \_\_\_\_\_  
 Totalizer Register Unit and Multiplier Factor (AF x .001, gal x 1000, etc): \_\_\_\_\_  
 Installation Date: \_\_\_\_\_ Meter installed by: \_\_\_\_\_  
 Is This Meter (check one):  New  Repaired  Replacement  
*Important: By submitting the above information you are certifying that this meter was installed to manufacturer standards. For agricultural wells, a list of approved meters is on the MDEQ website.*

I HEREBY CERTIFY that the above statements are true to the best of my knowledge.  
David West 0-672 8-4-2017 [Signature]  
 Print Name of Pump Installer and License No. (if applicable) Date Signature of Pump Installer