

Simpson
C 2001
10-10-75

MISSISSIPPI
 BOARD OF WATER COMMISSIONERS
 416 North State Street
 Jackson, Mississippi 39201

WATER WELL DRILLERS LOG


October 10 19 75 Hanna Well Service Simpson
 date well completed firm name county well located

LANDOWNER: <u>Travis Herrin</u>	description of formations encountered	from	to
Route 1			
<u>Braxton, Ms. 39044</u>	<u>Clayland Dirt</u>	<u>0</u>	<u>20</u>
<u>(mailing address)</u>	<u>Sand Rock</u>	<u>20</u>	<u>23</u>
<u>WELL LOCATION: Braxton 137</u>	<u>Sand Fine</u>	<u>23</u>	<u>30</u>
<u>sec. 11 T 2(N) R 3(E)</u>	<u>Blue Clay</u>	<u>30</u>	<u>35</u>
<u>S W</u>	<u>Blue Rock and Mix</u>	<u>35</u>	<u>40</u>
<u>1/2 miles East of Braxton</u>	<u>Dirt and Sand Mix</u>	<u>40</u>	<u>50</u>
<u>(distance) (direction) (nearest town)</u>	<u>Brown Rock</u>	<u>50</u>	<u>58</u>
<u>WELL PURPOSE: Emergency</u>	<u>Blue Clay</u>	<u>58</u>	<u>65</u>
<u>(home, irrigation, municipal, industrial)</u>	<u>Blue Rock</u>	<u>65</u>	<u>73</u>
<u>WELL COMPLETION DATA:</u>	<u>Blue and Dirt Mix</u>	<u>73</u>	<u>79</u>
(1) diameter (inches) <u>2</u>	<u>Coarse Sand</u>	<u>79</u>	<u>85</u>
(2) total depth (feet) <u>85</u>			
(3) static water level (feet) <u>25</u> below above top of ground.			
(4) casing <u>plastic 65 ft.</u>			
<u>(material) (depth)</u>			
<u>2</u> If telescope see back.			
<u>(size)</u>			
(5) screen <u>5 ft.</u>			
<u>(length) (depth to top)</u>			
<u>2 in. Plastic</u>			
<u>(size) (material)</u>			
(6) pump <u>Hand Pitcher</u>			
<u>(HP) (yield gpm)</u>			
<u>(type power)</u>			
(7) electric log <u>no</u>			
<u>(yes or no)</u>			
<u>(organization running log)</u>			
(8) how well bottom plugged <u>screen</u>			
<u>DRILLERS REMARKS:</u>			

NOV 6 1975
 MISS. BD. OF WATER COMMISSIONERS

If well telescopes please sketch and show depths.

GROUND LEVEL

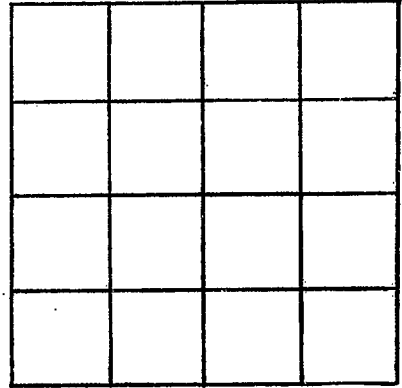

SECTION _____

Please indicate well location X.

ADDITIONAL INFORMATION

If more than one screen,
show locations of each on sketch.