

Simpson
C 2003
4-21-76

MISSISSIPPI
 BOARD OF WATER COMMISSIONERS
 416 North State Street
 Jackson, Mississippi 39201

WATER WELL DRILLERS LOG


4/21/76 1976 J. E. Thompson Simpson
 date well completed firm name county well located

LANDOWNER:	description of formations encountered	from	to
<u>Tommy Eason</u> <u>Broughton</u> (mailing address)			
	<u>sand.</u>	<u>140</u>	<u>160</u>
WELL LOCATION:			
sec <u>16</u> T <u>2</u> N R <u>3</u> E B W			
<u>2</u> miles <u>W</u> of <u>Broughton</u> (distance) (direction) (nearest town)			
WELL PURPOSE: (home, irrigation, municipal, industrial)			
WELL COMPLETION DATA:			
(1) diameter (inches) <u>4"</u>			
(2) total depth (feet) <u>160</u>			
(3) static water level (feet) <u>70'</u> below above top of ground.			
(4) casing <u>Plastic 160'</u> (material) (depth)			
<u>4"</u> If telescope see back. (size)			
(5) screen <u>5'</u> <u>135'</u> (length) (depth to top)			
<u>008</u> <u>Plastic</u> (size) (material)			
(6) pump <u>1/2</u> <u>13</u> (HP) (yield gpm)			
<u>Sub.</u> (type power)			
(7) electric log <u>no</u> (yes or no)			
(organization running log)			
(8) how well bottom plugged <u>4/21/76</u>			
DRILLERS REMARKS:			

RECEIVED
 JUL 8 1976
 MISS. BD. OF WATER COMMISSIONERS

If well telescopes please sketch and show depths.

GROUND LEVEL

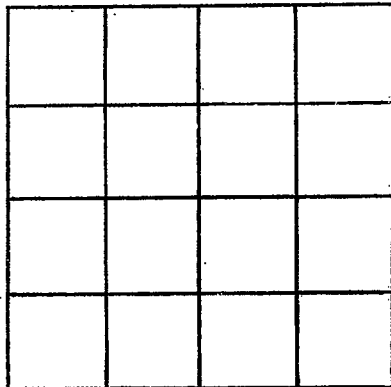

SECTION 151

Please indicate well location X.

ADDITIONAL INFORMATION

If more than one screen, show locations of each on sketch.