

Simpson
C 2005

MISSISSIPPI
BOARD OF WATER COMMISSIONERS
416 North State Street
Jackson, Mississippi 39201

11-8-79
11-8-79
date well completed

WATER WELL DRILLERS LOG

TOM Huffak
firm name

Simpson
county well located

LANDOWNER:
Burned Harris
Braxton
(mailing address)

description of formations encountered	from	to
TOP soil	0	1
Calv	1	160
Sand	160	205

WELL LOCATION:
sec. 2 T. 20 N R. 3 E
0 miles Braxton of Braxton
(distance) (direction) (nearest town)

WELL PURPOSE: Home
(home, irrigation, municipal, industrial)

- WELL COMPLETION DATA:
- (1) diameter (inches) 2"
 - (2) total depth (feet) 205'
 - (3) static water level (feet) 75' (below above top of ground)
 - (4) casing Plastic, 185'
" (material) (depth)
2" (size) If telescope see back.
 - (5) screen 20' 185'
" (length) (depth to top)
2" Plastic
" (size) (material)
 - (6) pump 1 None
(HP) (yield gpm)
Lead
(type power)
 - (7) electric log None
(yes or no)
None
(organization running log)
 - (8) how well bottom plugged B.W.V.

DRILLERS REMARKS:


DEPT. OF NATURAL RESOURCES
BUREAU OF LAND & WATER RESOURCES

JAN 7 1980

RECEIVED

If well telescopes please sketch and show depths.

GROUND LEVEL

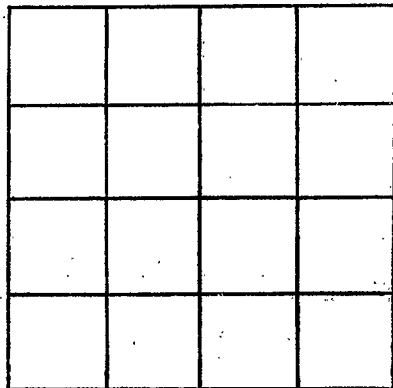

SECTION _____

Please indicate well location X.

ADDITIONAL INFORMATION

If more than one screen, show locations of each on sketch.