

Simpson
C 2000
12-22-79
12-22-79

MISSISSIPPI
BOARD OF WATER COMMISSIONERS
416 North State Street
Jackson, Mississippi 39201

WATER WELL DRILLERS LOG

TOM Griffith

Simpson

date well completed

firm name

county well located

LANDOWNER:	description of formations encountered	from	to
Edgar French	TOPSOIL	0	1'
Rt. 1 Box 15, BRANTON (mailing address)	CHALK Sand	1'	140'
WELL LOCATION:			
sec. 2 T 2 N R 3 S 1/2 mile East of Branton (distance) (direction) (nearest town)			
WELL PURPOSE: (home, irrigation, municipal, industrial)			
WELL COMPLETION DATA:			
(1) diameter (inches) 2"			
(2) total depth (feet) 200'			
(3) static water level (feet) 60' below top of ground.			
(4) casing Plastic, 200' (material) (depth)			
2" if telescope see back. (size)			
(5) screen 20' 180' (length) (depth to top)			
2" plastic (size) (material)			
(6) pump 1 (HP) (yield gpm)			
Eled (type power)			
(7) electric log No (yes or no)			
None (organization running log)			
(8) how well bottom plugged B.W.V.			
DRILLERS REMARKS:			

DEPT. OF NATURAL RESOURCES
BUREAU OF LAND & WATER RESOURCES


JAN 7 1980

RECEIVED

042

If well telescopes please sketch and show depths.

GROUND LEVEL

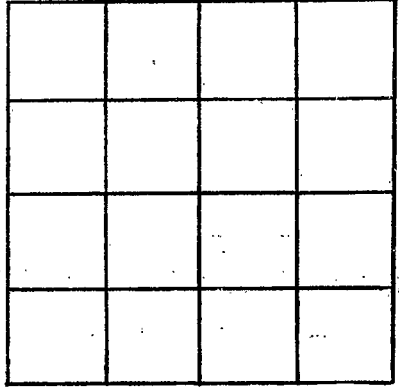

SECTION _____

Please indicate well location X.

ADDITIONAL INFORMATION

If more than one screen, show locations of each on sketch.