

MISSISSIPPI DEPARTMENT OF NATURAL RESOURCES
Bureau of Land and Water Resources
 Southport Mall
 P.O. Box 10631
 Jackson, Mississippi 39209
WATER WELL DRILLERS LOG

Simpson
C 2007

1981 Ray U. Wood & Dals Simpson
 date well completed firm name county well located

LANDOWNER:
A - Callahan James
B - Hester M S
 (mailing address)

description of formations encountered	from	to
CLAY	0	8
SAND CLAY STRIPS	8	54
CLAY	54	158
SAND	158	163
CLAY	163	323
SAND	323	390

WELL LOCATION:
 sec. 19 2 N 3 E
 S W
6 miles (distance) S.W. of Beantown (direction) (nearest town)

WELL PURPOSE:
 (home, irrigation, municipal, industrial)

- WELL COMPLETION DATA:**
- (1) diameter (inches) 4"
 - (2) total depth (feet) 390'
 - (3) static water level (feet) 160' below above top of ground.
 - (4) casing PVC (390' depth), 4" (size) if telescope see back.
 - (5) screen 10' (320' depth to top), 4" (size), PVC (material)
 - (6) pump 3 (HP), 40 (yield gpm), REA (type power)
 - (7) electric log NO (yes or no)
- (organization running log) _____
- (8) how well bottom plugged WASH VALVE

RECEIVED


OCT 13 1981

Department of Natural Resources
 Bureau of Land & Water Resources

DRILLERS REMARKS:

If well telescopes please sketch and show depths.

GROUND LEVEL

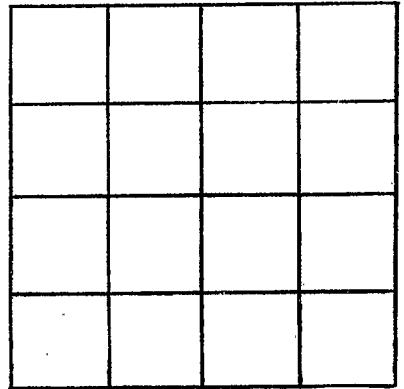

SECTION _____

Please indicate well location X.

ADDITIONAL INFORMATION

If more than one screen,
show locations of each on sketch.