

Simpson
 2008
 C
 Oct 4

MISSISSIPPI DEPARTMENT OF NATURAL RESOURCES
 Bureau of Land and Water Resources
 Southport Mall
 P.O. Box 10631
 Jackson, Mississippi 39209
 WATER WELL DRILLERS LOG

1981 *Prews Well Dr* *Simpson*
 date well completed firm name county well located

LANDOWNER:
Bobby Gordon
Central asphalt
Brookline Miss
 mailing address

WELL LOCATION:
 sec. *10* T. *2* N. R. *3* E
1 miles *West* of *Brookline*
 (distance) (direction) (nearest town)

WELL PURPOSE: *Home*
 (home, irrigation, municipal, industrial)

description of formations encountered	from	to
<i>Clay & gravel</i>	<i>0</i>	<i>15</i>
<i>hard blue clay</i>	<i>15</i>	<i>196</i>
<i>fine sand & clay</i>	<i>196</i>	<i>215</i>
<i>coarse sand</i>	<i>215</i>	<i>248</i>

WELL COMPLETION DATA:

(1) diameter (inches) *4"*

(2) total depth (feet) *248*

(3) static water level (feet) *150* below top of ground.

(4) casing *Plastic, caisson*
 (material) (depth)

_____ if telescope see back.
 (size)

(5) screen *10'* *238'*
 (length) (depth to top)

4" *plastic*
 (size) (material)

(6) pump *1/2 HP* *15'*
 (HP) (yield gpm)

shot
 (type power)

(7) electric log *no*
 (yes or no)

_____ (organization running log)

(8) how well bottom plugged *bad wash*

DRILLERS REMARKS:


DEPT. OF NATURAL RESOURCES
 BUREAU OF LAND & WATER RESOURCES

JUN 15 1982

RECEIVED

If well telescopes please sketch and show depths.

GROUND LEVEL

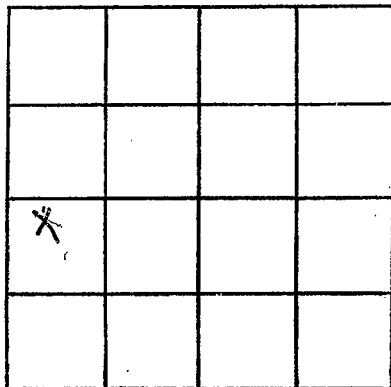

SECTION 10

Please indicate well location X.

ADDITIONAL INFORMATION

If more than one screen,
show locations of each on sketch.