

MISSISSIPPI DEPARTMENT OF NATURAL RESOURCES
 Bureau of Land and Water Resources
 Southport Mall
 P.O. Box 10631
 Jackson, Mississippi 39209
WATER WELL DRILLERS LOG

Simpson
 Co

April 12 19*82* *Reems Miller Simpson*
 date well completed firm name county well located

LANDOWNER:
Hilman Byrnes
Beaumont
 (mailing address)

description of formations encountered	from	to
<i>clay gravel</i>	<i>0</i>	<i>16</i>
<i>blue shale</i>	<i>16</i>	<i>190</i>
<i>hard rock chert</i>	<i>190</i>	<i>195</i>
<i>fine sand</i>	<i>195</i>	<i>205</i>
<i>coarse sand</i>	<i>215</i>	<i>224</i>

WELL LOCATION:
 sec. *4* T. *2* N R. *3* E
2 miles *N-NW* of *Beaumont*
 (distance) (direction) (nearest town)

WELL PURPOSE: *farm*
 (home, irrigation, municipal, industrial)

- WELL COMPLETION DATA:
- (1) diameter (inches) *4"*
 - (2) total depth (feet) *24 1/2*
 - (3) static water level (feet) *190* ^{below} / _{above} top of ground.
 - (4) casing *plastic latton*
 (material) (depth)
 - 2* (size) if telescope see back.
 - (5) screen *10'* *234'*
 (length) (depth to top)
 - 4"* *plastic*
 (size) (material)
 - (6) pump *1/2 hp* *15'*
 (HP) (yield gpm)
 - elect*
 (type power)
 - (7) electric log *no*
 (yes or no)
 - _____*
 (organization running log)
 - (8) How well bottom plugged *check mark*

DRILLERS REMARKS:


DEPT. OF NATURAL RESOURCES
 BUREAU OF LAND & WATER RESOURCES

AUG - 5 1982

RECEIVED

If well telescopes please sketch and show depths.

GROUND LEVEL

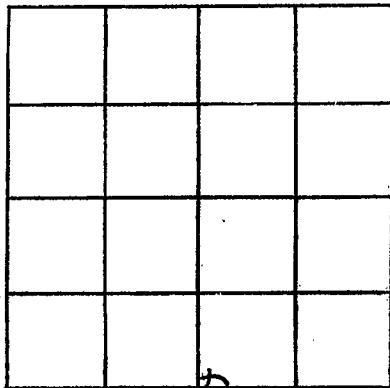

SECTION 4

Please indicate well location X.

ADDITIONAL INFORMATION

If more than one screen,
show locations of each on sketch.