

Simpson
C2010

MISSISSIPPI
BOARD OF WATER COMMISSIONERS
416 North State Street
Jackson, Mississippi 39201

WATER WELL DRILLERS LOG

9-24 1983 Bevin Wellser Simpson
date well completed firm name county well located

LANDOWNER:	description of formations encountered	from	to
<u>L. C. PAPP</u> (mailing address)	<u>CLAY</u> <u>Sand</u>	<u>0</u> <u>340</u>	<u>340</u> <u>360</u>
WELL LOCATION: sec <u>33</u> T <u>2</u> N R <u>3</u> E miles _____ of _____ (distance) (direction) (nearest town)			
WELL PURPOSE: (home, irrigation, municipal, industrial)			
WELL COMPLETION DATA: (1) diameter (inches) <u>2"</u> (2) total depth (feet) <u>360</u> (3) static water level (feet) <u>140</u> below top of ground. (4) casing <u>PVC</u> <u>340</u> , (material) (depth) <u>2"</u> (size) if telescope see back. (5) screen <u>20</u> <u>PVC</u> (length) (depth to top) <u>2</u> <u>PVC</u> (size) (material) (6) pump <u>1</u> <u>3</u> (HP) (yield gpm) (type power) _____ (7) electric log _____ (yes or no) (organization running log) _____ (8) how well bottom plugged <u>Back</u>			
DRILLERS REMARKS:			


DEPT. OF NATURAL RESOURCES
BUREAU OF LAND & WATER RESOURCES

NOV - 9 1983

RECEIVED

If well telescopes please
sketch and show depths.

GROUND LEVEL

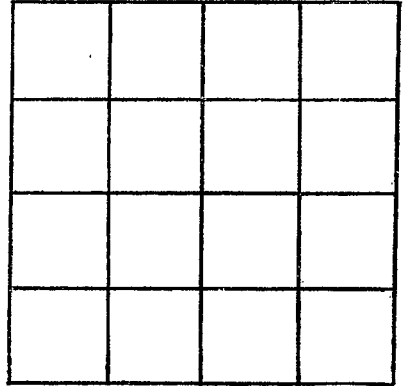

SECTION _____

Please indicate well location X.

ADDITIONAL INFORMATION

If more than one screen,
show locations of each on sketch.