

SIMPSON

D 3

6-19-70

MISSISSIPPI E LOG # 127

BOARD OF WATER COMMISSIONERS

416 North State Street

Jackson, Mississippi 39201

CODED

WATER WELL DRILLERS LOG

6/19

1970

H. E. Thompson

Simpson

date well completed

firm name

county well located

LANDOWNER:

James E. Lloyd

Mendenhall Miss.

(mailing address)

description of formations encountered

from

to

Surface clay 0 10

Rock stratum 10 55

Blue clay 55 160

160 208

WELL LOCATION:

sec. 1 T. 2 N. R. 4 E

5

miles

77

of

Mendenhall Miss.

(distance)

(direction)

(nearest town)

WELL PURPOSE:

home irrigation, municipal, industrial

WELL COMPLETION DATA:

- (1) diameter (inches) 2"
- (2) total depth (feet) 208
- (3) static water level (feet) 90' below top of ground.
- (4) casing Plastic 180' (material) (depth)  
2" (size) if telescope see back.
- (5) screen 8' 180' (length) (depth to top)  
2" (size) Plastic (material)
- (6) pump 2 (HP) 10 (yield gpm)  
Jet (type power)
- (7) electric log yes (yes or no)  
M.H.S. (organization running log)
- (8) how well bottom plugged By well

CODED


FEB 24 1971

MISS. BD. OF WATER COMM.

DRILLERS REMARKS:

If well telescopes please sketch and show depths.

GROUND LEVEL

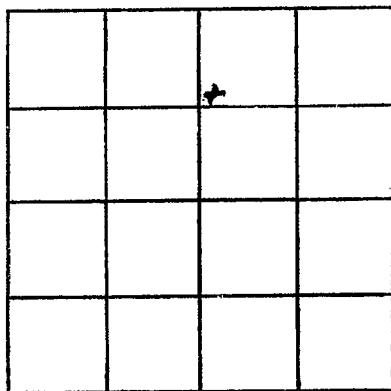

SECTION   K  

Please indicate well location X.

ADDITIONAL INFORMATION

If more than one screen,  
show locations of each on sketch.