

MISSISSIPPI  
 BOARD OF WATER COMMISSIONERS  
 416 North State Street  
 Jackson, Mississippi 39201

**CODED**

WATER WELL DRILLERS LOG

SIMPSON  
D 4  
9-12-70

Sept 12 1970 J. E. Thompson Simpson  
 date well completed firm name county well located

LANDOWNER:  
Paul Bailey  
Memphis  
 (mailing address)

description of formations encountered	from	to
<u>top soil</u>	<u>0</u>	<u>15</u>
<u>sandy</u>	<u>15</u>	<u>20</u>
<u>gray clay &amp; B.C.</u>	<u>40</u>	<u>150</u>
<u>sand</u>	<u>150</u>	<u>168</u>

WELL LOCATION:  
 sec. 36 T 2 N R 4 E  
1 miles E of Memphis  
 (distance) (direction) (nearest town)

WELL PURPOSE: home  
 (home, irrigation, municipal, industrial)

- WELL COMPLETION DATA:
- (1) diameter (inches) 2"
  - (2) total depth (feet) 168'
  - (3) static water level (feet) 130' below above top of ground.
  - (4) casing Plastic 165'  
 (material) (depth)  
2" if telescope see back.  
 (size)
  - (5) screen 5' 165'  
 (length) (depth to top)  
2" Plastic  
 (size) (material)
  - (6) pump 2 4  
 (HP) (yield gpm)  
Inst.  
 (type power)
  - (7) electric log no  
 (yes or no)
  - (organization running log)
  - (8) how well bottom plugged B/2/2

**CODED**


DEC 16 1970

DRILLERS REMARKS:

MISS. BD. OF  
 WATER COMM.

If well telescopes please sketch and show depths.

GROUND LEVEL

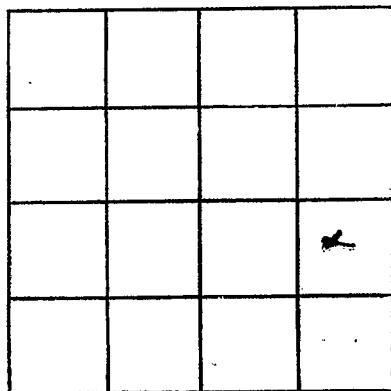

SECTION 36

Please indicate well location X.

ADDITIONAL INFORMATION

If more than one screen,  
show locations of each on sketch.