

SIMPSON MISSISSIPPI BOARD OF WATER COMMISSIONERS

D 6  
5-17-65

WATER WELL DRILLERS LOG

**CODED**

El May 50  
Simpson

Date: 5/17, 1965, Driller: Forest Drilling County: Forest  
(Name)

- (1) Owner of Land: Jung D'Lo.  
(Name)  
D'Lo, Miss.  
(Address)
- (2) Location: 1/4, 1/4, Sec. 28 T2 R1,  
miles 0.5 of D'Lo.  
(distance) (direction) (Nearest Town)
- (3) Topography: \_\_\_\_\_  
(Hilly) (Flat) (Level)
- (4) Purpose of Well: City well  
(Domestic Irrigation  
Municipal, Industrial, Other)


Description & Color of Materials Sand, Clay, Red Clay, Shell, etc.	Thick- ness Feet	Depth Feet
Clay		17
Green Rock		18
Chalky Clay		25
Sand		30
Yellow Clay		38
Clay		72
Green Rock		74
Soft Lenses & Shale		102
Hard Shale <b>CODED</b>		163
Shale		192
Med. Sand		212
Fine sand & lt. shale		212
Shale		237
Med. Sand		262

Information upon completion of well:

- (1) Diameter 6 inches.
- (2) Total Depth 262 feet.
- (3) Water Level 59 feet below top of ground.
- (4) Cased to 222, Size 6"
- (5) Screen: Size 6" Nom. Length 40ft.
- (6) Were any formations sealed against pollution?  
\_\_\_\_\_ yes, X no.

**CODED**

If YES depth of formation \_\_\_\_\_  
Why \_\_\_\_\_  
Drillers Remarks: \_\_\_\_\_

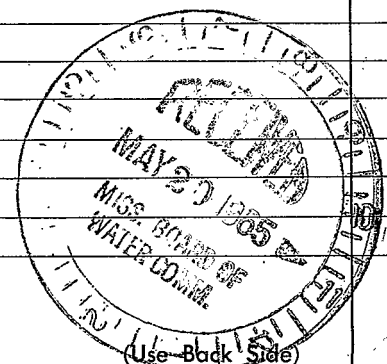

Well No.

①