

D7  
7-13-62

WATER WELL DRILLERS LOG CODED


Date: July 13, 1962 Driller: W. G. Butler County Smith  
(Name)

(1) Owner of Land:	Description & Color of Materials Sand, Clay, Red Clay, Shell, etc.	Thick- ness Feet	Depth Feet
<u>Wilson Barker</u> (Name)	<u>Clay</u>	<u>1-6</u>	<u>6</u>
<u>Mendenhall, Rt. 1 - Miss</u> (Address)	<u>Rock</u>	<u>6-10</u>	<u>10</u>
(2) Location: <u>1/4</u> , <u>1/4</u> , Sec. <u>24 T2 R4E</u> <u>11</u> miles <u>Miles</u> of <u></u> (distance) (direction) (Nearest Town)	<u>Chalk + Rock</u>	<u>10-40</u>	<u>40</u>
	<u>Red Sand</u>	<u>40-45</u>	<u>45</u>
	<u>Rock</u>	<u>45-80</u>	<u>80</u>
	<u>Chalk + Sand</u>	<u>70-80</u>	<u>80</u>
(3) Topography: <input checked="" type="checkbox"/> (Hilly) <input type="checkbox"/> (Flat) <input type="checkbox"/> (Level)	<u>Rock + Fine Sand</u>	<u>80-90</u>	<u>90</u>
	<u>" " "</u>	<u>90-110</u>	<u>110</u>
(4) Purpose of Well: <u>Domestic</u> (Domestic Irrigation Municipal, Industrial, Other)	<u>Sand + Rock</u>	<u>110-120</u>	<u>120</u>
	<u>Rock</u>	<u>120-125</u>	<u>125</u>
	<u>Sand</u>	<u>125-136</u>	<u>136</u>

Information upon completion of well:

- (1) Diameter 2 inches.
- (2) Total Depth 136 feet.
- (3) Water Level 70 feet below top of ground.
- (4) Cased to 126, Size 3"
- (5) Screen: Size 2", Length 10
- (6) Were any formations sealed against pollution?  
       yes,        no.

If YES depth of formation         
Why         
Drillers Remarks:       

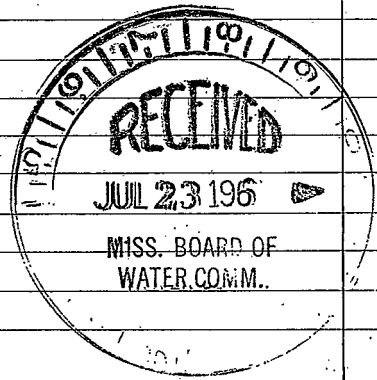

(Use Back Side)

Well No.

