

Simpson  
D 14  
10-67

MISSISSIPPI  
 BOARD OF WATER COMMISSIONERS  
 416 North State Street  
 Jackson, Mississippi 39201

CODED

WATER WELL DRILLERS LOG

W. G. Butler

Oct. 12 1967 date well completed  
 1967 Water Well Service firm name  
 SIMPSON county well located

LANDOWNER: John Phillips  
D'Lo Miss -  
RT -  
 (mailing address)

WELL LOCATION:  
 sec. 9 T. 2 N. R. 4 E.  
2 1/2 miles N of D'Lo  
 (distance) (direction) (nearest town)

WELL PURPOSE: Home  
 (home, irrigation, municipal, industrial)

WELL COMPLETION DATA:


- (1) diameter (inches) 2"
- (2) total depth (feet) 726
- (3) static water level (feet) 160 <sup>below</sup> top of ground.
- (4) casing galv. 701  
 (material) (depth)  
2" if telescope see back.  
 (size)
- (5) screen 15 701  
 (length) (depth to top)  
2 stainless  
 (size) (material)
- (6) pump Air Comp.  
 (HP) (yield gpm)  
Electric 1000 w  
 (type power)
- (7) electric log No  
 (yes or no)  
 (organization running log)
- (8) how well bottom plugged 2" B.W.V.

| description of formations encountered | from | to  |
|---------------------------------------|------|-----|
| Rock + chalk                          | 1    | 30  |
| Sand + chalk                          | 30   | 60  |
| Chalk                                 | 60   | 80  |
| Rock + chalk                          | 80   | 110 |
| Rock                                  | 110  | 120 |
| Rock + sand                           | 120  | 130 |
| Sand + chalk                          | 130  | 140 |
| Sand                                  | 140  | 150 |
| Rock + sand                           | 150  | 172 |
| Rock + chalk                          | 172  | 177 |
| Sand                                  | 177  | 190 |
| Rock                                  | 190  | 210 |
| Rock + sand                           | 210  | 220 |
| Sand                                  | 220  | 231 |
| Sand + chalk                          | 231  | 241 |
| " "                                   | 241  | 252 |
| Chalk                                 | 252  | 273 |
| Chalk + shell                         | 273  | 280 |
| Rock + shell                          | 280  | 304 |
| Lignite + sand                        | 304  | 315 |
| Chalk                                 | 315  | 325 |
| Sand + chalk                          | 325  | 357 |
| Chalk                                 | 357  | 367 |
| Sand + chalk                          | 367  | 378 |
| Clay + sand                           | 378  | 430 |
| Clay                                  | 430  | 441 |
| Rock                                  | 441  | 448 |
| Clay + rock                           | 448  | 451 |
| Clay                                  | 451  | 472 |
| Clay + shell, rock                    | 472  | 491 |
| Shell + clay                          | 491  | 511 |
| Clay                                  | 511  | 633 |
| Sand + clay                           | 633  | 693 |
| Sand                                  | 693  | 713 |
| Sand - clay                           | 713  | 726 |

DRILLERS REMARKS:

If well telescopes please sketch and show depths.

GROUND LEVEL

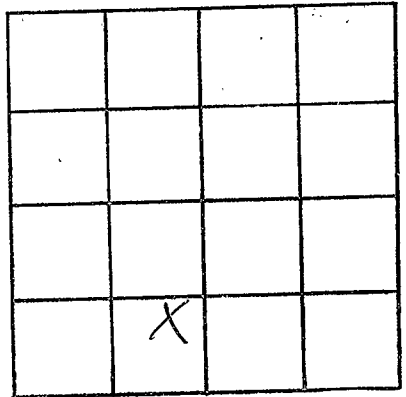

SECTION 9

Please indicate well location X.

ADDITIONAL INFORMATION

If more than one screen, show locations of each on sketch.