

SIMPSON MISSISSIPPI BOARD OF WATER COMMISSIONERS

D 15

3-8-66

WATER WELL DRILLERS LOG

CODED

Date: Mar 8, 1966, Driller: W. H. Bullard County Simpson  
 (Name)

(1) Owner of Land: George Muse  
 (Name)  
Mendenhall  
 (Address)

(2) Location: 1/4, 1/4, Sec 12 T21 R44 E  
6 miles S-W of Puckett  
 (distance) (direction) (Nearest Town)

(3) Topography:  (Level)  
 (Hilly)  (Flat)


(4) Purpose of Well: Domestic  
 (Domestic Irrigation  
 Municipal, Industrial, Other)

Description & Color of Materials Sand, Clay, Red Clay, Shell, etc.	Thick- ness Feet	Depth Feet
SAND + CHALK	1-10	
CHALK	10-20	
SAND + CHALK	20-40	
SAND	47-50	

Information upon completion of well:

- (1) Diameter 2' inches.
- (2) Total Depth 50' feet.
- (3) Water Level \_\_\_\_\_ feet below top of ground.
- (4) Cased to 42, Size 2"
- (5) Screen: Size 2", Length 5'
- (6) Were any formations sealed against pollution?  
 \_\_\_\_\_ yes, \_\_\_\_\_ no.

If YES depth of formation \_\_\_\_\_  
 Why \_\_\_\_\_  
 Drillers Remarks: \_\_\_\_\_

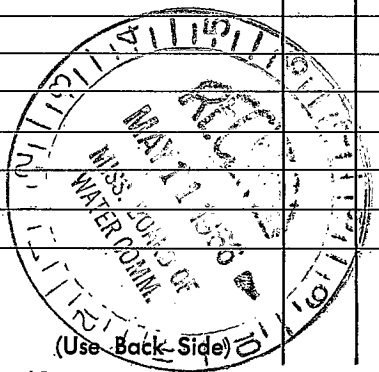

Well No.

(Use Back Side)

1910

1910