

D17
5-9-64

WATER WELL DRILLERS LOG

CODED

Date: May 9, 1964, Driller: W. H. Butler County Smith
(Name)

(1) Owner of Land: Wilson Barber
(Name)
Mendenhall, Miss.
(Address)
(2) Location: 1/4, 1/4, Sec. 24 T2 R54
3 miles N-E of Mendenhall
(distance) (direction) (Nearest Town)
(3) Topography: (Hilly) (Flat) (Level)
(4) Purpose of Well: Domestic
(Domestic Irrigation
Municipal, Industrial, Other)

Description & Color of Materials Sand, Clay, Red Clay, Shell, etc.	Thick- ness Feet	Depth Feet
Red clay	1-5	
sand	5-10	
chalk	10-15	
sand	15-20	
chalk + sand	20-30	
Rock + chalk	30-60	
chalk	60-68	
sand	68-98	

Information upon completion of well:


(1) Diameter 2" inches.
(2) Total Depth 98 feet.
(3) Water Level _____ feet below top of ground.
(4) Cased to 91', Size 2"
(5) Screen: Size 2", Length 6'
(6) Were any formations sealed against pollution?
_____ yes, _____ no.

If YES depth of formation _____

Why _____

Drillers Remarks: _____

CODED

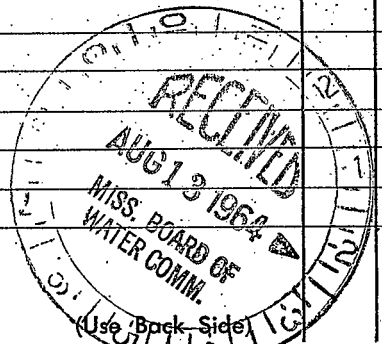

Well No.

Faint, illegible text covering the majority of the page, possibly bleed-through from the reverse side.

