

Date: 8/2-62, 1962, Driller: Raymond M. Mitty, County: Simpson

(1) Owner of Land: R & B poultry (Name)
mendelhall miss (Address)
(2) Location: 1/4, 1/4, Sec. 31 T4 R24
2 1/2 miles SW of Dils (distance) (direction) (Nearest Town)
(3) Topography: X (Hilly) (Flat) (Level)
(4) Purpose of Well: poultry down (Domestic Irrigation Municipal, Industrial, Other)

Table with 3 columns: Description & Color of Materials (Sand, Clay, Red Clay, Shell, etc.), Thickness Feet, Depth Feet. Rows include: Red clay (15, 15), white shell (74, 55), Blue shell (95, 150), Fine sand (12, 162), blue shell (106, 268), white sand (12, 280).


Information upon completion of well:

(1) Diameter 2 inches.
(2) Total Depth 280 feet.
(3) Water Level 85 feet below top of ground.
(4) Cased to, Size.
(5) Screen: Size 1/4, Length 10 ft.
(6) Were any formations sealed against pollution?
yes, no.

CODED

If YES depth of formation
Why

Drillers Remarks:

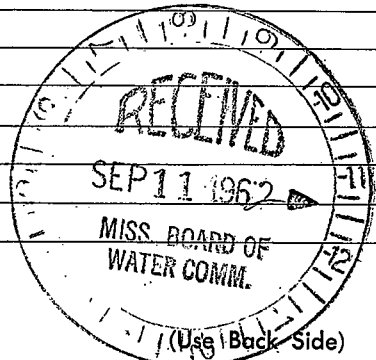

Well No.

1000