

SIMPSON MISSISSIPPI BOARD OF WATER COMMISSIONERS

D20

8-13-60

D-300

WATER WELL DRILLERS LOG

Date: 8/13, 1960, Driller: James A. White ^{Simpson} ~~1900~~ Smith county

(Name)

(1) Owner of Land: Douglas E. Waller
(Name)

Rt 2 Mendenhall
(Address)

(2) Location: NE 1/4, SW 1/4, Sec. 10 T2R4

4 1/2 miles NE of D'Lo
(distance) (direction) (Nearest Town)

(3) Topography: (Hilly) (Flat) (Level)

(4) Purpose of Well: chicken farm
(Domestic Irrigation, Municipal, Industrial, Other)

Description & Color of Materials
Sand, Clay, Red Clay, Shell, etc.

Thick-
ness
Feet

Depth
Feet

<u>Red clay 20</u>	<u>20</u>	<u>20</u>
<u>Shell</u>	<u>170</u>	<u>190</u>
<u>Gravel</u>	<u>10</u>	<u>200</u>

Information upon completion of well:

(1) Diameter 2 inches.

(2) Total Depth 200 feet.

(3) Water Level 75 feet below top of ground.

(4) Cased to 173, Size 2

(5) Screen: Size round, Length _____


(6) Were any formations sealed against pollution?

_____ yes, _____ no.

If YES depth of formation _____

Why _____

Drillers Remarks: _____

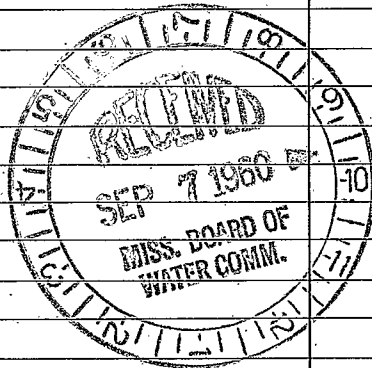

(Use Back Side)

Well No.

1911

1912

1913

1914

1915

1916