

SIMPSON

D 24

MISSISSIPPI BOARD OF WATER COMMISSIONERS

7-24-65

CODED

WATER WELL DRILLERS LOG

Date: July 24 19 65, Driller: W. G. Butler, County: SIMPSON

(When well drilled)

(Name)

(Where well is located)

(1) Owner of Land: Sidney Watkins
(Name)
BRAYTON, MISS.
(Address)

(2) Location: 1/4, 1/4, Sec. 3 T. R.
on Cato Road -
4 miles N, of D'Lo
(distance) (direction) (Nearest Town)

(3) Topography: (Hilly) (Flat) (Level)

(4) Purpose of Well: Domestic
(Domestic Irrigation
Municipal, Industrial, Other)

Description & Color of Materials Sand, Clay, Red Clay, Shell, etc.	Thick- ness Feet	Depth Feet
Chalk	1-10	
Rock	10-25	
Sand	25-30	
Rock	30-35	
Sand	35-50	
Chalk + Rock	50-90	
Rock	90-100	
Rock + Chalk	100-150	
Sand + Chalk	150-170	
Sand	170-195	

Information upon completion of well:

(1) Diameter 2" inches.

(2) Total Depth 195' feet.

(3) Water Level _____ feet below top of ground.

(4) Cased to 180, Size 2"

(5) Screen: Size 2", Length 10

(6) Were any formations sealed against pollution?
_____ yes, _____ no.

If YES depth of formation _____


Why _____

Drillers Remarks: _____

Yield in gpm: _____

Size pump: _____

Type power: _____

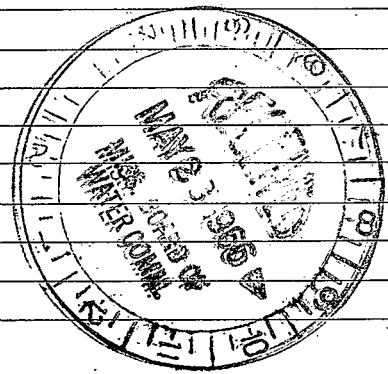

Mail this copy to Board of Water Commissioners 429 Miss. St. Jackson, Miss.

