

SIMPSON
 6 D 25
 9-16-63

MISSISSIPPI BOARD OF WATER COMMISSIONERS

WATER WELL DRILLERS LOG

CODED

Date: 9-16-1963, Driller: Layne-Central Co. County Simpson
 (Name)

(1) Owner of Land: Simpson County Bd. of Supervisors
 (Name)
 Mendenhall, Mississippi
 (Address)

(2) Location: 1/4, 1/4, Sec. 15 T. R.
 _____ miles _____ of _____
 (distance) (direction) (Nearest Town)

(3) Topography: _____
 (Hilly) (Flat) (Level)

(4) Purpose of Well: School
 (Domestic Irrigation
 Municipal, Industrial, Other)

| Description & Color of Materials Sand, Clay, Red Clay, Shell, etc. | Thick- ness Feet | Depth Feet |
|-----------------------------------------------------------------------|------------------------|---------------|
| red sandy clay | 4 | 4 |
| white clay | 38 | 42 |
| sand, red clay stks. | 24 | 66 |
| loose sand | 11 | 77 |
| hard clay, sand stks | 28 | 105 |
| hard clay | 80 | 185 |
| hard shale | 183 | 368 |
| sand, med. coarse | 42 | 410 |
| shale, sand stks | 80 | 490 |
| sand, last 15' fine | 70 | 560 |
| shale | 5 | 565 |

Information upon completion of well:

(1) Diameter 10 inches.

(2) Total Depth 545 feet.

(3) Water Level 101 feet below top of ground.

(4) Cased to 493', Size 10"

(5) Screen: Size 6", Length 40'


(6) Were any formations sealed against pollution?
 yes, _____ no.

If YES depth of formation 493'

Why _____ required

Drillers Remarks: _____

CODED

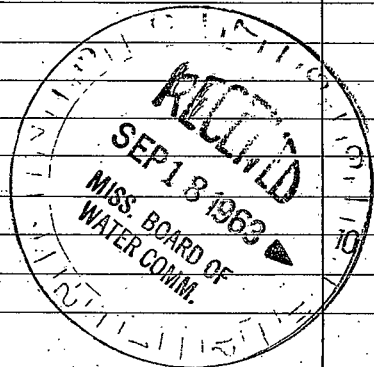

(Use Back Side)

Well No.

Mail this copy to Board of Water Commissioners 429 Miss. St. Jackson, Miss.

14