

D 26
4-18-62

WATER WELL DRILLERS LOG

Date: 4/18, 1962, Driller: Jay Gatt, County: Simpson

Hattiesburg, Butone James

(1) Owner of Land: Mrs Ruth Gatt
(Name) well
Mendenhall, Mrs
(Address)

(2) Location: 1/4, 1/4, Sec. 15 T R
miles, of
(distance) (direction) (Nearest Town)

(3) Topography: (Hilly) (Flat) (Level)

(4) Purpose of Well: (Domestic Irrigation, Municipal, Industrial, Other)


Description & Color of Materials Sand, Clay, Red Clay, Shell, etc.	Thick- ness Feet	Depth Feet
red clay	0	10
white sand	10	30
white clay	35	45
lime rock	45	60
white clay	60	80
blue clay	85	130
white sand	130	165

Information upon completion of well:

- (1) Diameter 2" inches.
- (2) Total Depth 170 feet.
- (3) Water Level 90 feet below top of ground.
- (4) Cased to 2", Size 2"
- (5) Screen: Size 2, Length 5'
- (6) Were any formations sealed against pollution?
yes, no.

If YES depth of formation
Why
Drillers Remarks:

CODED

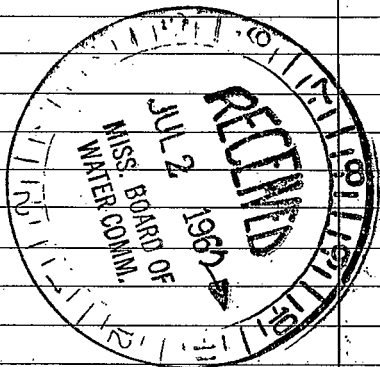

(Use Back Side)

Well No.

