

SIMPSON
 6 & D28
 6-68

MISSISSIPPI
 BOARD OF WATER COMMISSIONERS
 416 North State Street
 Jackson, Mississippi 39201

CODED

WATER WELL DRILLERS LOG


June 8, 1968 date well completed Thompson Well Co. firm name Lumberton county well located

LANDOWNER:	description of formations encountered	from	to
Thomas R. Pender			
R.T. Pender (mailing address)	sand	5	15
WELL LOCATION:	clay	15	16
sec 1 T 1 N 5 R 4 E	sand	16	21
3 miles D.P. of Pender (distance) (direction) (nearest town)	white clay	21	77
WELL PURPOSE: (home, irrigation, municipal, industrial)	Water supply	77	87
WELL COMPLETION DATA:			
(1) diameter (inches) 2"			
(2) total depth (feet) 87'			
(3) static water level (feet) 46 below top of ground			
(4) casing 2" (material) 78' (depth) if telescope see back.			
(5) screen 9' (length) 78' (depth to top) 1 1/2" (size) Brass (material)			
(6) pump 1-2 HP (HP) 10 (yield gpm) Elk (type power)			
(7) electric log no (yes or no)			
(organization running log)			
(8) how well bottom plugged Packed			
DRILLERS REMARKS:			

JUN 11 1968
 MISS. BOARD OF WATER COMMISSIONERS
 JACKSON, MISSISSIPPI

If well telescopes please sketch and show depths.

GROUND LEVEL

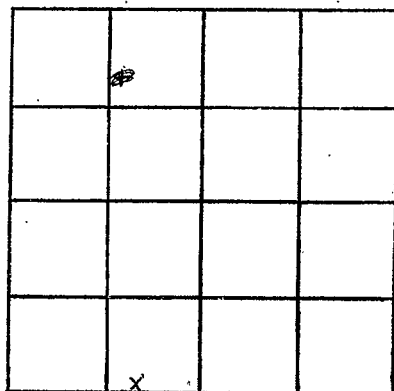

SECTION 15

Please indicate well location X.

ADDITIONAL INFORMATION

If more than one screen, show locations of each on sketch.