

SIMPSON
D 32
8-68


MISSISSIPPI
BOARD OF WATER COMMISSIONERS
416 North State Street
Jackson, Mississippi 39201

CODED
CODED

WATER WELL DRILLERS LOG

aug 1/1968 19 W.E. Thompson W. Simpson
date well completed firm name county well located

LANDOWNER:	description of formations encountered	from	to
<u>Mrs. Ruth Lott</u>	<u>tan fine clay</u>	0	48
<u>Merrell miss.</u> (mailing address)	<u>sand</u>	48	50
WELL LOCATION: <u>N 9° E NW</u> sec. <u>35</u> T. <u>2</u> N. R. <u>4</u> E	<u>rock</u>	50	53
<u>1</u> miles <u>NE</u> of <u>Merrell</u> (distance) (direction) (nearest town)	<u>sand</u>	53	60
WELL PURPOSE: <u>home</u> (home, irrigation, municipal, industrial)	<u>sand rock</u>	60	70
WELL COMPLETION DATA:	<u>6 1/2" diameter</u>		
(1) diameter (inches) <u>4</u>	<u>gray soft rock</u>	70	80
(2) total depth (feet) <u>185</u>	<u>gray clay</u>	80	94
(3) static water level (feet) <u>117</u> below top of ground.	<u>sand</u>	94	96
(4) casing <u>Alumite, 160'</u> (material) (depth)	<u>blue clay</u>	96	150
<u>4"</u> if telescope see back. (size)	<u>fine sand</u>	150	155
(5) screen <u>10'</u> , <u>175'</u> (length) (depth to top)	<u>blue rock</u>	155	157
<u>2"</u> <u>Stokes Well</u> (size) (material)	<u>fine sand</u>	157	167
(6) pump <u>1/2</u> <u>10</u> (HP) (yield gpm)	<u>auger cut</u>	167	185
<u>Sub.</u> (type power)			
(7) electric log <u>no</u> <u>MBS</u> (yes or no)			
(organization running log)			
(8) how well bottom plugged <u>8/21/68</u>			

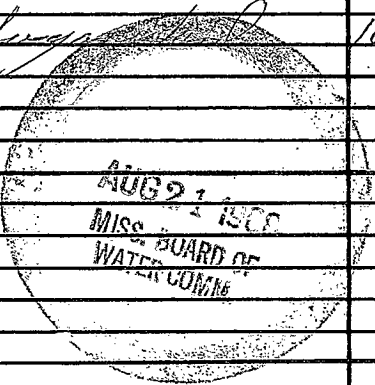

DRILLERS REMARKS:

