

13T

**CODED**

Simpson  
D 33  
5-26-68

MISSISSIPPI  
BOARD OF WATER COMMISSIONERS  
416 North State Street  
Jackson, Mississippi 39201

**CODED**

WATER WELL DRILLERS LOG

May 26 1968 W. L. Butler Simpson  
date well completed firm name county well located

LANDOWNER: I. H. Zilind

Mendonhall

description of formations encountered	from	to
<u>Red sand &amp; clay</u>	<u>0</u>	<u>10</u>
<u>sand &amp; clay</u>	<u>10</u>	<u>20</u>
<u>" "</u>	<u>20</u>	<u>30</u>
<u>sand</u>	<u>30</u>	<u>47</u>

(mailing address)

WELL LOCATION:

sec. 12 2 N R 4E  
S W  
4 miles N of Mendon.  
(distance) (direction) (nearest town)


WELL PURPOSE: Home  
(home, irrigation, municipal, industrial)

WELL COMPLETION DATA:

- (1) diameter (inches) 2 1/2
- (2) total depth (feet) 47
- (3) static water level (feet) \_\_\_\_\_ below/above top of ground.
- (4) casing galv., 42'  
(material) (depth)  
2" if telescope see back.  
(size)
- (5) screen 5', 42'  
(length) (depth to top)  
2", Brass  
(size) (material)
- (6) pump \_\_\_\_\_ (HP) \_\_\_\_\_ (yield gpm)  
Electric  
(type power)
- (7) electric log No  
(yes or no)
- \_\_\_\_\_ (organization running log)
- (8) how well bottom plugged 2" BWL

**CODED**

**CODED**

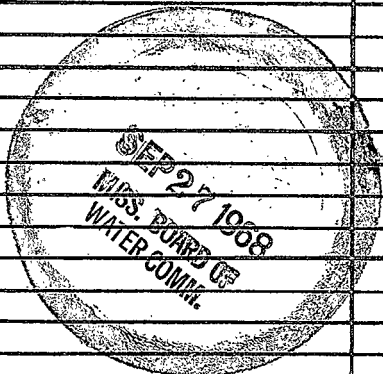

DRILLERS REMARKS:

