

MISSISSIPPI
BOARD OF WATER COMMISSIONERS
416 North State Street
Jackson, Mississippi 39201

CODED

CODED

WATER WELL DRILLERS LOG

13T

Simpson
D35
11-4-68

11-4 date well completed 168 W.K. Barnes Water Wells Inc. firm name Simpson county well located

LANDOWNER: Mr. Boyd
Mount Olive
Route Miss.
(mailing address)

description of formations encountered	from	to
Red clay	0	5
yellow clay	14	22
red sand	27	29
Blue clay	29	30
Rock	35	57
Blue clay	57	69
Fine sand	69	86
Course sand	86	91

WELL LOCATION:
sec. 25 T. 2 (N) R. 4 (E)
S W
7 miles South of Puckett
(distance) (direction) (nearest town)

WELL PURPOSE: Hand
(home, irrigation, municipal, industrial)

- WELL COMPLETION DATA:
- (1) diameter (inches) 2
- (2) total depth (feet) 91
- (3) static water level (feet) 41 below above top of ground.
- (4) casing Galv. 97
(material) (depth)
2" if telescope see back.
(size)
- (5) screen 4' 91
(length) (depth to top)
078lat. Stainless Steel
(size) (material)
- (6) pump 3/4 8
(HP) (yield gpm)
Elec
(type power)
- (7) electric log no
(yes or no)
(organization running log)
- (8) how well bottom plugged wash valve

CODED


CODED

MISSISSIPPI
BOARD OF WATER COMMISSIONERS
JAN 10 1968

DRILLERS REMARKS:

If well telescopes please sketch and show depths.

GROUND LEVEL

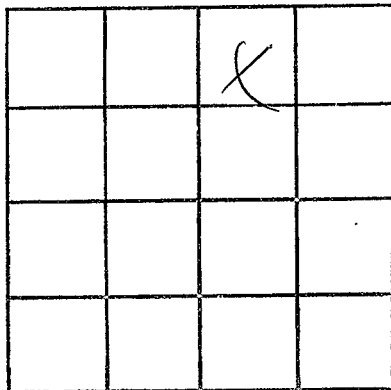

SECTION 25

Please indicate well location X.

ADDITIONAL INFORMATION

If more than one screen, show locations of each on sketch.