

Simpson Co.  
 D 40  
 7-69

MISSISSIPPI  
 BOARD OF WATER COMMISSIONERS  
 416 North State Street  
 Jackson, Mississippi 39201

CODED

WATER WELL DRILLERS LOG

July 14, 1969 19 R. E. Thompson Well for Simpson  
 date well completed firm name county well located

LANDOWNER:  
James L. Lundy  
Mendenhall Weiss  
 (mailing address)

description of formations encountered	from	to
clay	0	18
sand & clay	18	45
clay	45	60
med. blue clay	60	155
sand & blue clay	155	180

WELL LOCATION:  
 sec. 1 T. 2 N. R. 4 E  
5 miles 7 of Madison  
 (distance) (direction) (nearest town)

WELL PURPOSE: home  
 (home, irrigation, municipal, industrial)

WELL COMPLETION DATA:

(1) diameter (inches) 2"

(2) total depth (feet) 180

(3) static water level (feet) 115' below top of ground.

(4) casing Plastic, 130'  
 (material) (depth)  
2" if telescope see back.  
 (size)

(5) screen open  
 (length) (depth to top)  
 (size) (material)

(6) pump 1 HP 6  
 (HP) (yield gpm)  
 (type power)

(7) electric log no  
 (yes or no)  
 (organization running log)

(8) how well bottom plugged open

CODED


AUG 7 1969

DRILLERS REMARKS:  
Sand was in 2' strip  
& 2' of blue clay  
at bottom

MISS. BD. OF  
 WATER COMM.

If well telescopes please sketch and show depths.

GROUND LEVEL

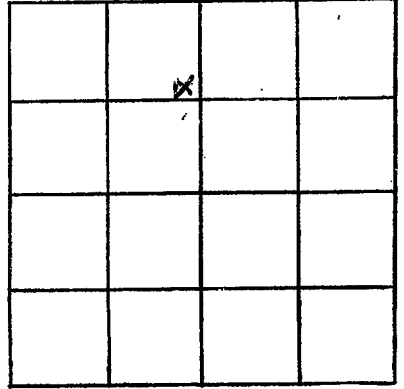

SECTION 1

Please indicate well location X.

ADDITIONAL INFORMATION

If more than one screen,  
show locations of each on sketch.