

Simpson Co
 D 41
 7-69

MISSISSIPPI
 BOARD OF WATER COMMISSIONERS
 416 North State Street
 Jackson, Mississippi 39201

WATER WELL DRILLERS LOG **CODED**

July 16, 1969 K. E. Thompson Wells Simpson
 date well completed firm name county well located

LANDOWNER:
 Mrs J. Lon Woods
 P. O. Miss.
 (mailing address)

description of formations encountered	from	to
clay & rock	0	18
sand	18	22

WELL LOCATION:
 sec 30 T 2 N R 4 E
 1 1/2 miles West of P. O.
 (distance) (direction) (nearest town)

Bray clay & rock	22	160
lime sand	160	180

WELL PURPOSE: Home
 (home, irrigation, municipal, industrial)

Blue clay & rock	180	270
------------------	-----	-----

WELL COMPLETION DATA:

- (1) diameter (inches) 2"
- (2) total depth (feet) 295'
- (3) static water level (feet) 26' below top of ground
- (4) casing Plastic, 295' (material) (depth)
 2" (size) If telescope see back.
- (5) screen 10' 280' (length) (depth to top)
 2" Plastic (size) (material)
- (6) pump air 30 (HP) (yield gpm)
 air (type power)
- (7) electric log Yes (yes or no)
 M. H. S. (organization running log)
- (8) how well bottom plugged B/W valve

sand	270	290
B Clay	290	295

CODED


AUG 7 1969

MISS. BD. OF
 WATER COMMISSIONERS

DRILLERS REMARKS:

If well telescopes please sketch and show depths.

GROUND LEVEL

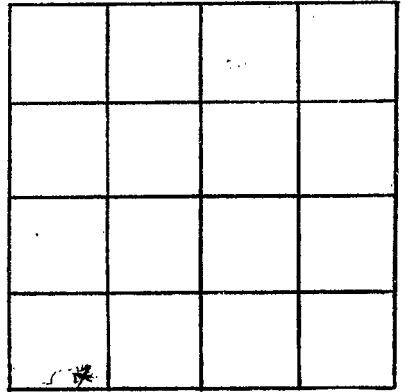

SECTION _____

Please indicate well location X. 30

ADDITIONAL INFORMATION

If more than one screen, show locations of each on sketch.