

Simpson  
D43  
12-12-69

MISSISSIPPI  
 BOARD OF WATER COMMISSIONERS  
 416 North State Street  
 Jackson, Mississippi 39201

CODED

WATER WELL DRILLERS LOG

Dec-12 1969 W. G. Butler Simpson  
 date well completed firm name county well located

LANDOWNER: Anna Harper  
Mendonhall, Miss  
 (mailing address) Rt-

WELL LOCATION:  
 sec. 17 T. 2 S. R. 4 E. W.  
 miles \_\_\_\_\_ of \_\_\_\_\_  
 (distance) (direction) (nearest town)

WELL PURPOSE: Home  
 (home, irrigation, municipal, industrial)

description of formations encountered	from	to
<u>SAND + CLAY</u>	<u>10</u>	<u>60</u>
<u>CLAY</u>	<u>60</u>	<u>70</u>
<u>CLAY + ROCK</u>	<u>70</u>	<u>100</u>
<u>CLAY</u>	<u>100</u>	<u>105</u>
<u>SAND</u>	<u>105</u>	<u>110</u>
<u>CLAY</u>	<u>110</u>	<u>120</u>
<u>ROCK + CLAY</u>	<u>120</u>	<u>284</u>
<u>CLAY + SAND</u>	<u>204</u>	<u>214</u>
<u>CLAY + ROCK</u>	<u>210</u>	<u>234</u>
<u>CLAY</u>	<u>230</u>	<u>237</u>
<u>SAND</u>	<u>237</u>	<u>247</u>
<u>CLAY + ROCK</u>	<u>247</u>	<u>254</u>

WELL COMPLETION DATA:

(1) diameter (inches) 2"

(2) total depth (feet) 254

(3) static water level (feet) 130 below/above top of ground.

(4) casing 921K 237  
 (material) (depth)  
2" If telescope see back.  
 (size)

(5) screen 10' 237  
 (length) (depth to top)  
2" SS  
 (size) (material)

(6) pump 1 6  
 (HP) (yield gpm)  
Electric  
 (type power)

(7) electric log NO  
 (yes or no)

(organization running log)


(8) how well bottom plugged 2" B.V.

JAN - 8 1970  
 MISS. BD. OF  
 WATER COMM.

DRILLERS REMARKS:

If well telescopes please sketch and show depths.

GROUND LEVEL

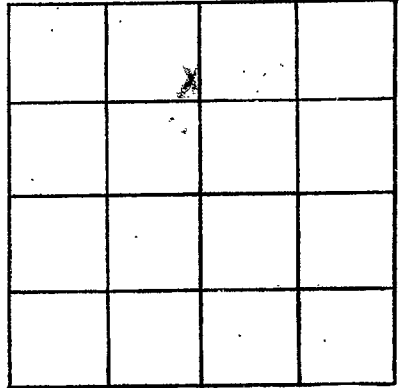

SECTION           

Please indicate well location X.

ADDITIONAL INFORMATION

If more than one screen,  
show locations of each on sketch.