

SIMPSON
D44
5-19-70

MISSISSIPPI
BOARD OF WATER COMMISSIONERS
416 North State Street
Jackson, Mississippi 39201

ELOG #124

CODED

WATER WELL DRILLERS LOG

5/19 date well completed 1970 R. E. Thompson firm name Simpson county well located

LANDOWNER: Rosie Barnes
D. L. Miss (mailing address)
WELL LOCATION: sec. 29 T 2 N R 4 E 1 miles S/W of P. H. (distance) (direction) (nearest town)
WELL PURPOSE: Home (home, irrigation, municipal, industrial)

description of formations encountered	from	to
Sandy clay	0	23
Blue clay	23	52
Green sand	52	72
Clay blue	72	170
Sand	170	192

WELL COMPLETION DATA:
(1) diameter (inches) 2"
(2) total depth (feet) 192
(3) static water level (feet) 60 below top of ground.
(4) casing (material) Plastic (depth) 170'
(size) 2" If telescope see back.
(5) screen (length) 10' (depth to top) 170'
(size) 2" (material) Plastic
(6) pump (HP) 1 (yield gpm) 6
(type power) Electric
(7) electric log yes (yes or no)
(organization running log) M. H. S.
(8) how well bottom plugged Block

CODED

FER 2 1/2 1971


MISS. BD. OF WATER COMM.

DRILLERS REMARKS:

12

If well telescopes please sketch and show depths.

GROUND LEVEL

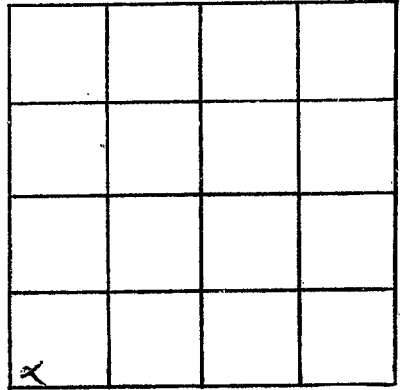

SECTION 27

Please indicate well location X.

ADDITIONAL INFORMATION

If more than one screen,
show locations of each on sketch.