

E LOG #132

MISSISSIPPI
BOARD OF WATER COMMISSIONERS
416 North State Street
Jackson, Mississippi 39201

CODED

WATER WELL DRILLERS LOG

SIMPSON
D45
1-4-71

Jan 4 1971 Thompson Well Dr. Simpson
date well completed firm name county well located

LANDOWNER Raymond Faucett
Raymond Faucett
Hubert...
(mailing address)

| description of formations encountered | from | to |
|---------------------------------------|------------|------------|
| <u>Top soil.</u> | <u>0</u> | <u>15</u> |
| <u>Red clay.</u> | <u>15</u> | <u>30</u> |
| <u>Blue clay</u> | <u>30</u> | <u>130</u> |
| <u>150 Shale of sand</u> | <u>130</u> | <u>150</u> |
| <u>150 Blue clay</u> | <u>150</u> | <u>172</u> |
| <u>Sand</u> | <u>172</u> | <u>190</u> |

WELL LOCATION:
sec 16 T 2 N R 4 E
1 miles N of P. Lor.
(distance) (direction) (nearest town)

WELL PURPOSE: home
(home, irrigation, municipal, industrial)

- WELL COMPLETION DATA:
- (1) diameter (inches) 2"
 - (2) total depth (feet) 190'
 - (3) static water level (feet) 90 below above top of ground.
 - (4) casing 2" 185'
(material) (depth)
2" 181' if telescope see back.
(size)
 - (5) screen 3" 185'
(length) (depth to top)
2" 185'
(size) (material)
 - (6) pump 1 1/2 10
(HP) (yield gpm)
Just
(type power)
 - (7) electric log yes
(yes or no)
M. H. S.
(organization running log)
 - (8) how well bottom plugged By...

CODED


FEB 8 1971

DRILLERS REMARKS:

MISC. DD. 05
WATER COMMISSIONERS

If well telescopes please sketch and show depths.

GROUND LEVEL

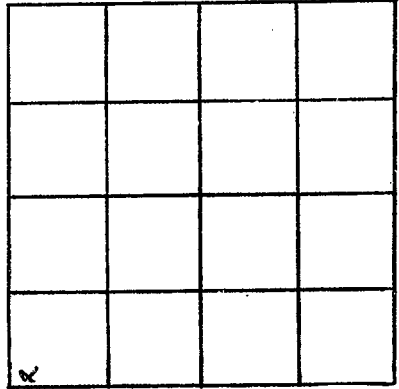

SECTION 16

Please indicate well location X.

ADDITIONAL INFORMATION

If more than one screen, show locations of each on sketch.