

SIMPSON
D47
12-70

MISSISSIPPI
BOARD OF WATER COMMISSIONERS
416 North State Street
Jackson, Mississippi 39201

CODED

WATER WELL DRILLERS LOG

Dec 19 70 R. E. Thompson Simpson
date well completed firm name county well located

LANDOWNER:	description of formations encountered	from	to
<u>Effer Tiller</u>	<u>top soil.</u>	<u>0</u>	<u>10</u>
<u>D. L. Miss.</u> (mailing address)	<u>White clay.</u>	<u>10</u>	<u>35</u>
WELL LOCATION: sec <u>30</u> T <u>2</u> N R <u>4</u> E S W	<u>Blue clay.</u>	<u>35</u>	<u>76</u>
<u>1</u> miles <u>S</u> of <u>D. L.</u> (distance) (direction) (nearest town)	<u>sand.</u>	<u>76</u>	<u>85</u>
WELL PURPOSE: <u>home</u> (home, irrigation, municipal, industrial)	<u>Blue clay.</u>	<u>85</u>	<u>235</u>
WELL COMPLETION DATA:	<u>sand.</u>	<u>235</u>	<u>240</u>
(1) diameter (inches) <u>2"</u>	<u>Blue clay.</u>	<u>240</u>	<u>250</u>
(2) total depth (feet) <u>262</u>	<u>sand.</u>	<u>250</u>	<u>262</u>
(3) static water level (feet) <u>90</u> below top of ground. above			
(4) casing <u>Plastic 160'</u> (material) (depth)			
<u>2"</u> (size) if telescope see back.			
(5) screen <u>open hole.</u> (length) (depth to top)			
(size) (material)			
(6) pump (HP) (yield gpm)			
(type power)			
(7) electric log (yes or no)			
(organization running log)			
(8) how well bottom plugged			
DRILLERS REMARKS: <u>this well</u> <u>is not completed they</u> <u>will not pay. water</u> <u>line is coming soon.</u>			


CODED

MISS. 7 1971

MISS. BD. OF
WATER COMM.

If well telescopes please sketch and show depths.

GROUND LEVEL

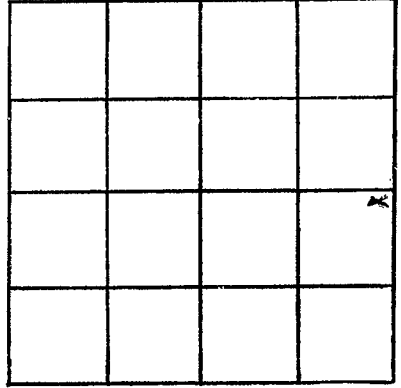

SECTION 30

Please indicate well location X.

ADDITIONAL INFORMATION

If more than one screen, show locations of each on sketch.