

SIMPSON

~~RETRACTED~~

D 48

6-19-71

MISSISSIPPI  
BOARD OF WATER COMMISSIONERS  
416 North State Street  
Jackson, Mississippi 39201

**CODED**

W. G. Butler  
WATER WELL DRILLERS LOG

June 19 1971 Ray Milner Rankin  
date well completed firm name county well located

LANDOWNER:

Ray Milner

Mendenhall, Miss  
(mailing address) Rt.

WELL LOCATION:

sec. 1 T 2 N R 4 E  
S W  
5 miles N of Mendenhall  
(distance) (direction) (nearest town)

WELL PURPOSE:

Home  
(home, irrigation, municipal, industrial)

WELL COMPLETION DATA:

- (1) diameter (inches) 2"
- (2) total depth (feet) 190'
- (3) static water level (feet) 80' <sup>below</sup>/<sub>above</sub> top of ground.
- (4) casing galv. 195'  
(material) (depth)  
2" if telescope see back.  
(size)
- (5) screen 5'  
(length) (depth to top)  
24 S.S.  
(size) (material)
- (6) pump Air Comp 12  
(HP) (yield gpm)  
Electric  
(type power)
- (7) electric log No  
(yes or no)

(organization running log)

(8) how well bottom plugged 2" B.W.V.

description of formations encountered

from to

<u>Clay + Sand</u>	<u>0</u>	<u>20</u>
<u>Rock Clay, Sand</u>	<u>20</u>	<u>40</u>
<u>Clay</u>	<u>40</u>	<u>60</u>
<u>Sand + Clay</u>	<u>60</u>	<u>70</u>
<u>Rock + Clay</u>	<u>70</u>	<u>100</u>
<u>Sand</u>	<u>100</u>	<u>128</u>
<u>Clay</u>	<u>128</u>	<u>150</u>
<u>Clay + Sand</u>	<u>130</u>	<u>170</u>
<u>Sand</u>	<u>170</u>	<u>180</u>
<u>Clay</u>	<u>180</u>	<u>190</u>

**CODED**


JUL 16 1971

MISS. BD. OF  
WATER COMM.

DRILLERS REMARKS:

If well telescopes please sketch and show depths.

GROUND LEVEL

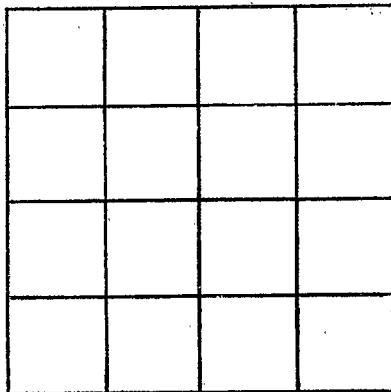

SECTION \_\_\_\_\_

Please indicate well location X.

ADDITIONAL INFORMATION

If more than one screen, show locations of each on sketch.