

SIMPSON
D52
6-31-74

MISSISSIPPI
BOARD OF WATER COMMISSIONERS
416 North State Street
Jackson, Mississippi 39201

CODED

WATER WELL DRILLERS LOG

June 31 1974 W. G. Butler Simpson
date well completed firm name county well located

LANDOWNER:

Jimmie Mason
Mendenhall, Miss
(mailing address)

description of formations encountered

from to

Clay & Sand	0	30
mod. clay	30	40
Clay & Rocks	40	50
Clay	50	60
Sand	58	65
Clay & Sand	65	70
Sand	70	75
Rocks & Clay	75	150
Clay	150	160
Clay & Sand	160	185
Sand	185	190
Clay & Sand	190	205
Sand	205	210

WELL LOCATION:

sec. 19 T. 2 N R. 4 E
S W
13 miles N.E. of Mendenhall
(distance) (direction) (nearest town)

WELL PURPOSE:

(home, irrigation, municipal, industrial)

WELL COMPLETION DATA:

- (1) diameter (inches) 2"
- (2) total depth (feet) 210'
- (3) static water level (feet) 75' below top of ground.
- (4) casing galv. 205' (material) (depth)
2" (size) If telescope see back.
- (5) screen 5' 205' (length) (depth to top)
2" (size) S.S. (material)
- (6) pump 3/4 (HP) 6 (yield gpm)
(type power)
- (7) electric log (yes or no)
(organization running log)
- (8) how well bottom plugged

CODED


RECEIVED
JUL 30 1974

DRILLERS REMARKS:

MISS. BD. OF WATER COMMISSIONERS

If well telescopes please sketch and show depths.

GROUND LEVEL

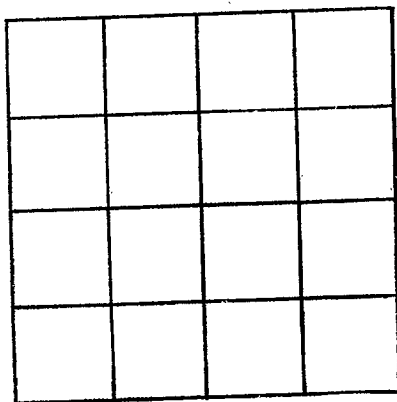

SECTION _____

Please indicate well location X.

ADDITIONAL INFORMATION

If more than one screen,
show locations of each on sketch.