

SIMPSON  
 D55  
 8-5-77  
 E Log # 186

MISSISSIPPI  
 BOARD OF WATER COMMISSIONERS  
 416 North State Street  
 Jackson, Mississippi 39201

CODED

WATER WELL DRILLERS LOG

5-5 19 77 JACK GUNN SIMPSON  
 date well completed firm name county well located

LANDOWNER: FOLWERS, H.S.  
 (mailing address)  
 WELL LOCATION:  
 sec 9 T 2 N R 4 E  
 miles of  
 (distance) (direction) (nearest town)

description of formations encountered	from	to
Red SAND	0	40
CLAY	40	115
SANDY HARD	115	160
CLAY	160	195
SAND	195	215

WELL PURPOSE:  
 (home, irrigation, municipal, industrial)

WELL COMPLETION DATA:  
 (1) diameter (inches) 4  
 (2) total depth (feet) 215  
 (3) static water level (feet) 44 below above top of ground.  
 (4) casing PVC 195 (material) (depth)  
 4" If telescope see back. (size)  
 (5) screen 20 195 (length) (depth to top)  
 4" PVC (size) (material)  
 (6) pump 1/2 15 (HP) (yield gpm)  
 MPC (type power)  
 (7) electric log Yes (yes or no)  
 MGS (organization running log)  
 (8) how well bottom plugged B.W.V


CODED

RECEIVED  
 SEP 16 1977

DRILLERS REMARKS:

If well telescopes please sketch and show depths.

GROUND LEVEL

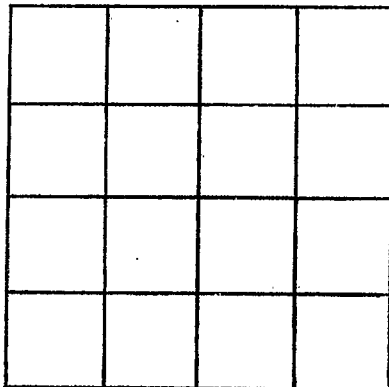

SECTION \_\_\_\_\_

Please indicate well location X.

ADDITIONAL INFORMATION

If more than one screen, show locations of each on sketch.