

SIMPSON

MISSISSIPPI BOARD OF WATER COMMISSIONERS
416 North State Street
Jackson, Mississippi 39201

CODED

~~156~~ D56

6/20/78 201

EL # 123

WATER WELL DRILLERS LOG

6/90 1978 Guinn Waterworks Simpson
date well completed firm name county well located

Jack D

LANDOWNER:

Joe Moss

(mailing address)

WELL LOCATION:

sec. 5 T 2 N R 4 E
S W

_____ miles of _____
(distance) (direction) (nearest town)

WELL PURPOSE:

(home, irrigation, municipal, industrial)

WELL COMPLETION DATA:

- (1) diameter (inches) 2
- (2) total depth (feet) 178
- (3) static water level (feet) 100 below above top of ground.
- (4) casing PVC 158
(material) (depth)
- 2 if telescope see back.
(size)
- (5) screen 90 158
(length) (depth to top)
- 2 PVC
(size) (material)
- (6) pump 1 4
(HP) (yield gpm)
- _____ (type power)
- (7) electric log _____ (yes or no)
MGS
(organization running log)
- (8) how well bottom plugged 1300

description of formations encountered

from to

CLAY SAND

0 130
130 178

CODED


DRILLERS REMARKS:

RECEIVED
JUL 31 1978

MISS. Bd. OF WATER COMMISSIONERS

If well telescopes please sketch and show depths.

GROUND LEVEL

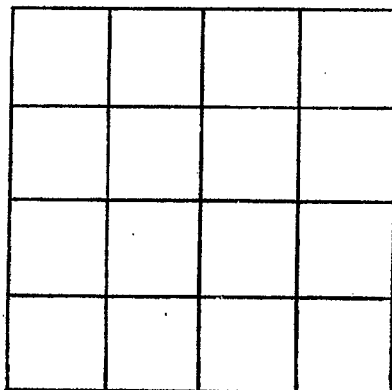

SECTION _____

Please indicate well location X.

ADDITIONAL INFORMATION

If more than one screen,
show locations of each on sketch.