

SIMPSON
 D64
 5181
 Elog #265
 MAY 19 81

MISSISSIPPI
 BOARD OF WATER COMMISSIONERS
 416 North State Street
 Jackson, Mississippi 39201

CODED

WATER WELL DRILLERS LOG

date well completed 19 81 GRINER DRILLING CO. SIMPSON
 firm name county well located

LANDOWNER: TOWN OF
 D'LO
 well no. 5
 (mailing address)

description of formations encountered	from	to
Top soil	0	2
Yellow CLAY	2	7
SANDY SHALE	7	14
CLAY w/ sand streaks	14	149
Sand, Fine	149	179
CLAY	179	179
Sand, white	179	228
Sand, Blue	228	238
SANDY BLUE	238	257

WELL LOCATION: NW 1/4
 NE 1/4 NW 1/4
 sec. 28 T 2 N R 4 E W

miles (distance) of (direction) (nearest town)

WELL PURPOSE:
 (home, irrigation, municipal, industrial)

- WELL COMPLETION DATA:
- (1) diameter (inches) 10 3/4"
 - (2) total depth (feet) 236
 - (3) static water level (feet) 58 below top of ground.
 - (4) casing Steel 190' (material) (depth)
 10 3/4" (size) If telescope see back.
 - (5) screen 40 196 (length) (depth to top)
 6" 304 S.S. (.016) (size) (material)
 - (6) pump 25 200 (HP) (yield gpm)
 Elect. (type power)
 - (7) electric log Yes (yes or no)
 MGS (organization running log)
 - (8) how well bottom plugged BACK
 WASH VALVE

CODED

DEPT. OF NATURAL RESOURCES
 BUREAU OF LAND & WATER RESOURCES

JUN 2 1981


RECEIVED

DRILLERS REMARKS:

(7)

If well telescopes please sketch and show depths.

GROUND LEVEL

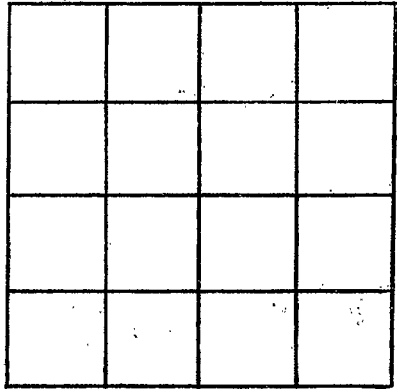

SECTION _____

Please indicate well location X.

ADDITIONAL INFORMATION

If more than one screen, show locations of each on sketch.